


T.3N.,R.34E.,W.M.

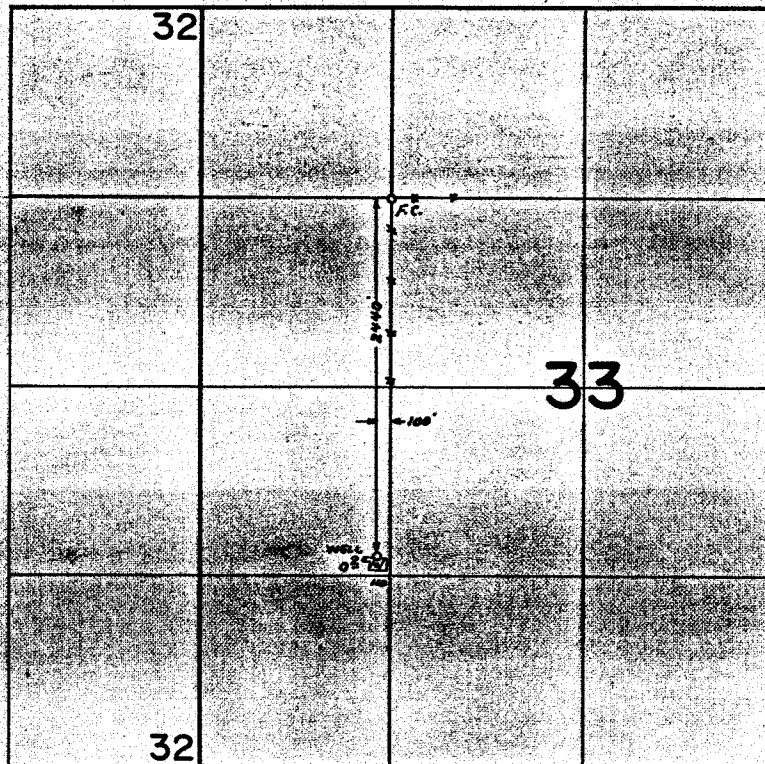

FINAL PROOF SURVEY
UNDER

Application No. G-4653 Permit No. G-4377
IN NAME OF

LAYTON L. MANN

Surveyed April 4, 1975, by L. Tall