


T.15S. R.47E. W.M.

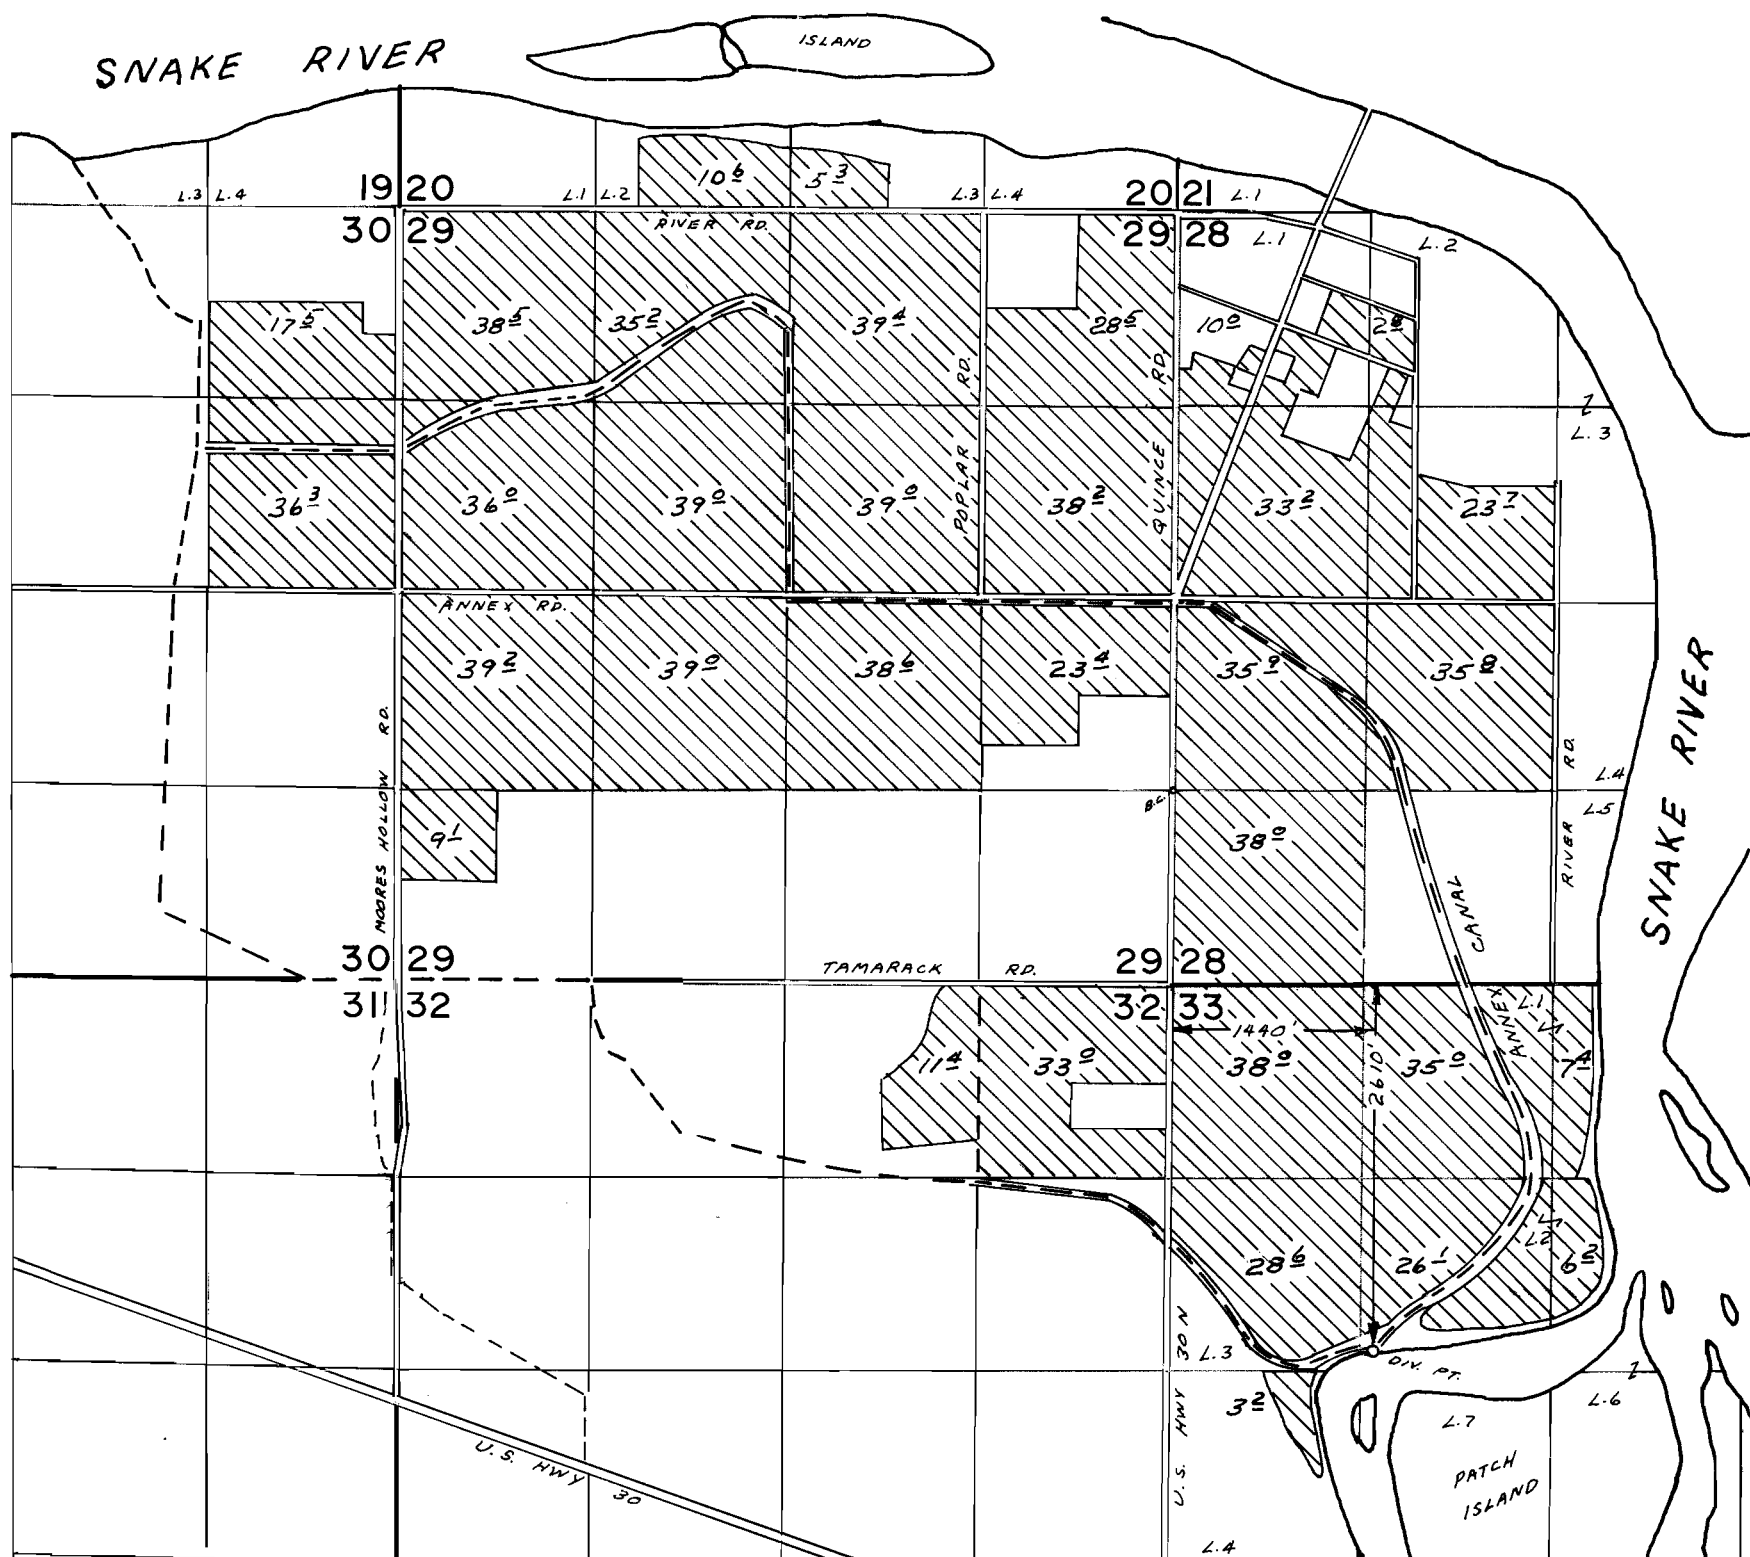

FINAL PROOF SURVEY

UNDER

APPLICATION NO. 43111 PERMIT NO. 32216

IN NAME OF

MALEUR DISTRICT IMPROVEMENT COMPANY

SURVEYED MAY 6, 1975, BY L.H. NUNN

BBC-2KK-263
BBC-2KK-320