


T.5S.,R.IW.,W.M.

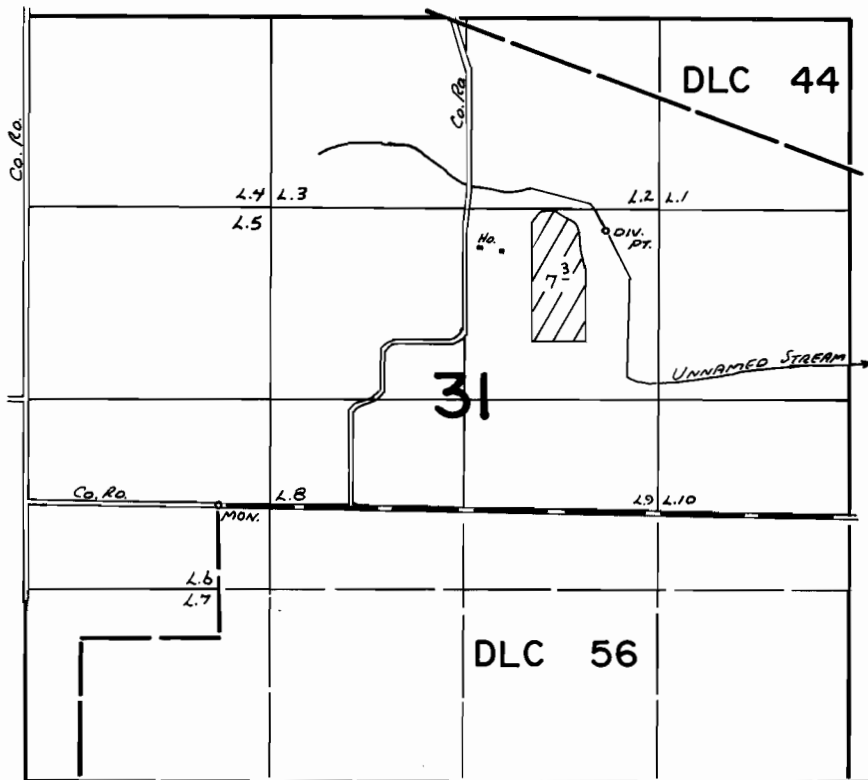

FINAL PROOF SURVEY UNDER

Transfer No. 2965
 Application No. Permit No.
 IN NAME OF

CLARENCE SCHLECHTER

Surveyed APRIL 2, 1976, by L. TOLL