


T. 6S. R.2W. W.M.

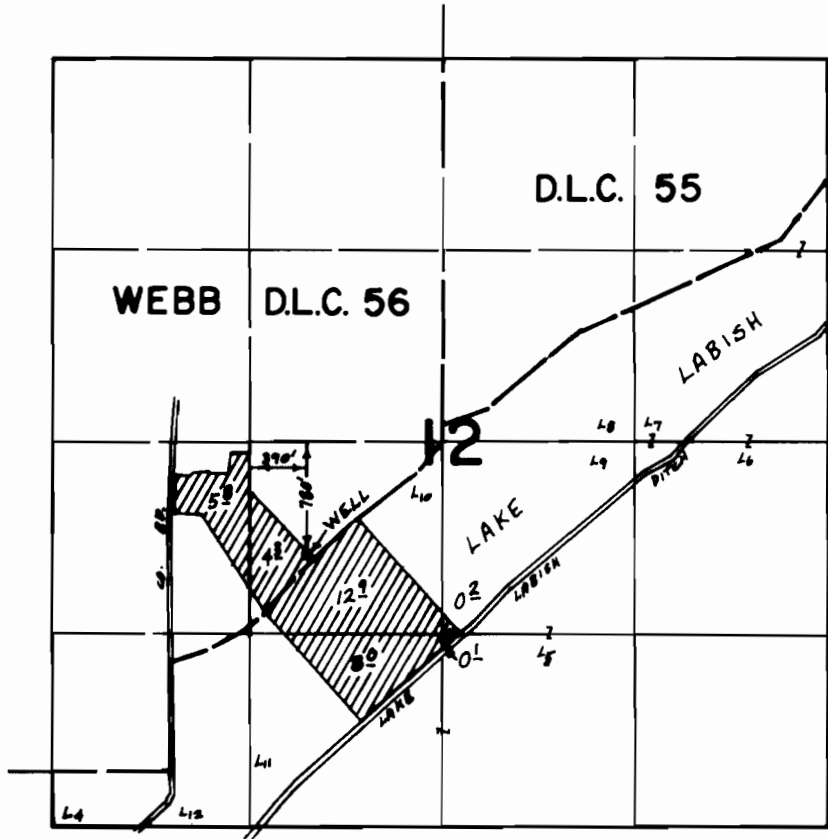

**FINAL PROOF SURVEY**  
UNDER

Application No. G-6159 Permit No. G-5203  
IN NAME OF

PETER SPROED & JIM PFAU

Surveyed MAY 28, 1975, by L. H. NUNN