


T.4S.,R.1W.,W.M.

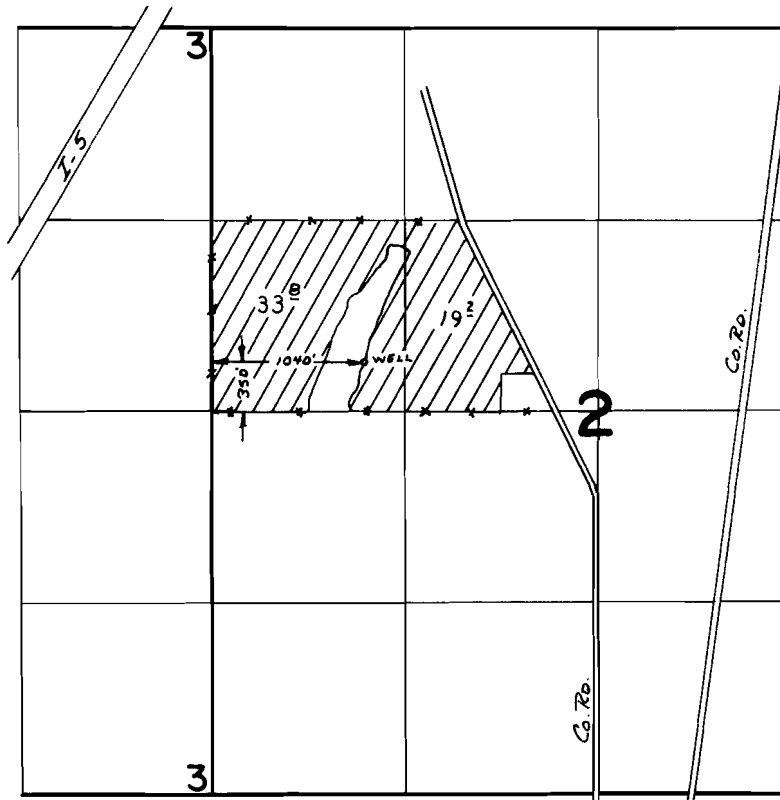

FINAL PROOF SURVEY
UNDER

Application No. G-5406 Permit No. G-5341
IN NAME OF

NORMAN J. MCDONALD

Surveyed Oct. 3 1975, by L. Toll