


T.7S.,R.2W.,W.M.

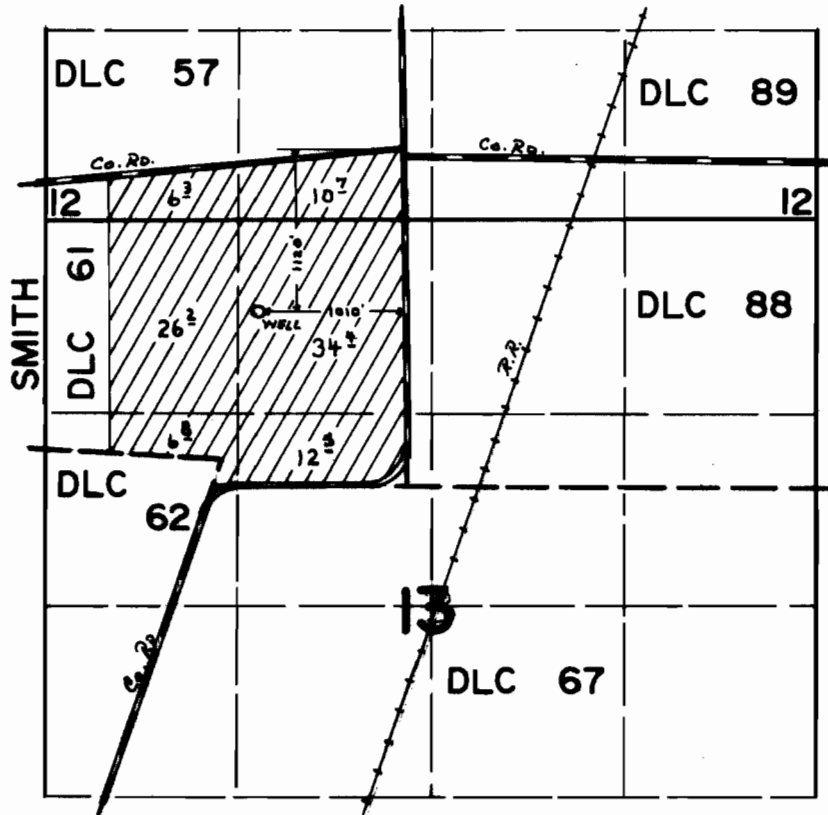

FINAL PROOF SURVEY UNDER

Application No. G-5570 Permit No. G-5436
IN NAME OF

.....RALPH HERR.....

Surveyed Oct. 1 1975, by L. Toll