


# T.6S.,R.1W.,W.M.

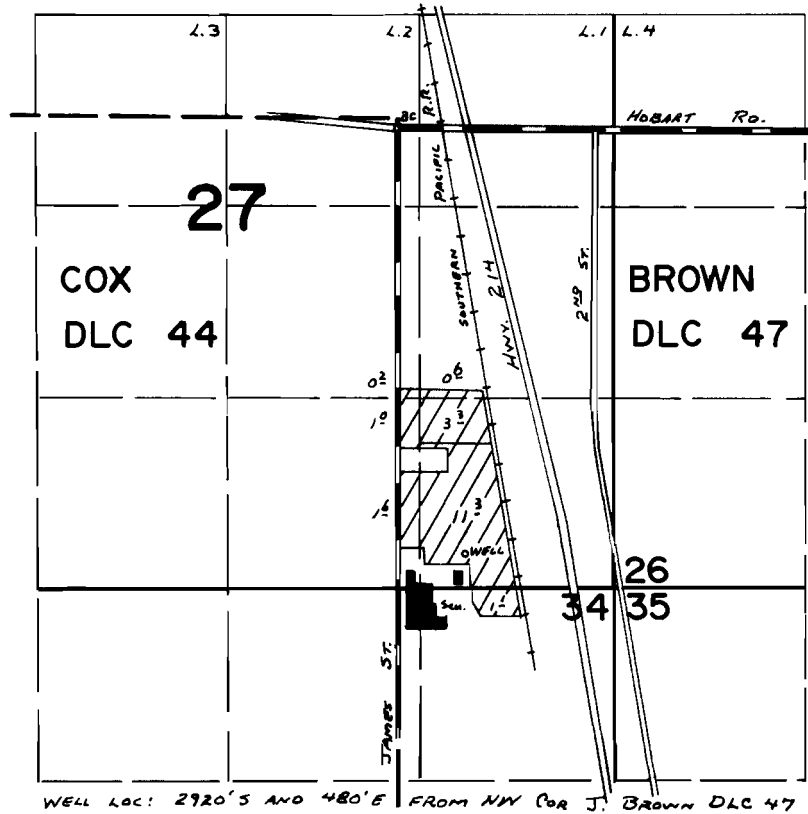

## FINAL PROOF SURVEY UNDER

Application No. G-5606 Permit No. G-5452  
 IN NAME OF  
 SILVERTON UNION  
 HIGH SCHOOL DIST. "7-J"

Surveyed SEPT. 29 1975, by L. Tell