


T.7S., R.1W., W.M.

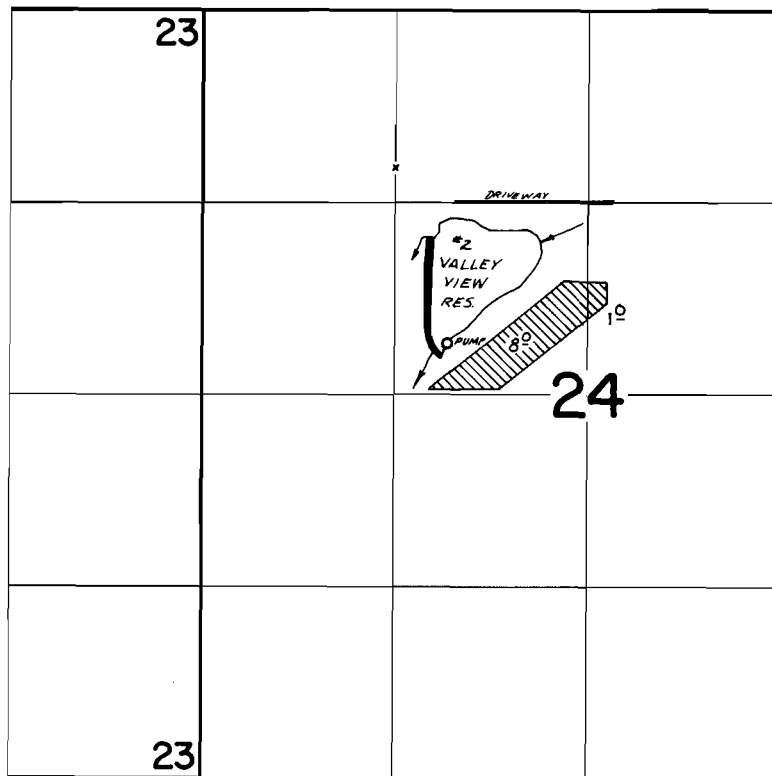

RES. LOC: 1020'S & 260'E FROM NW COR. SE 1/4 NW 1/4 SEC 24

FINAL PROOF SURVEY
UNDER

Application No. R-48077 48078 Permit No. R-5651 35251
IN NAME OF

S. AMOS AND ARDYTHE M. FUNRUE

Surveyed Aug. 4 1975, by D. Norby