


T.8S. R.6W. W.M.

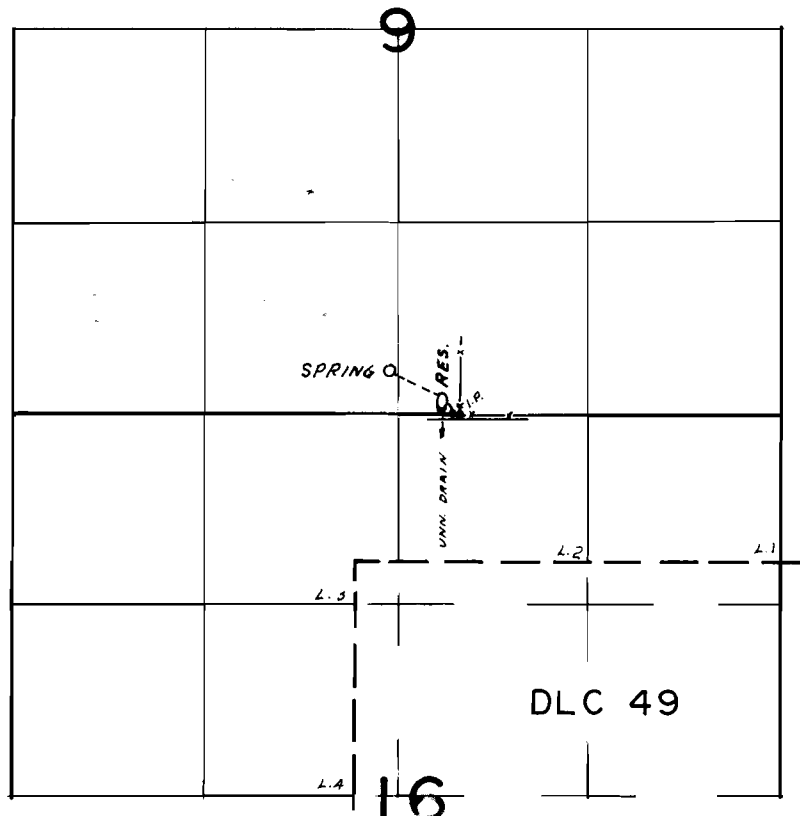

SPRING LOC. 30' N. & 20' W. FROM S. 1/4 COR. SEC. 9
DAM LOC. 30' N. & 300' E. FROM S. 1/4 COR. SEC. 9

FINAL PROOF SURVEY
UNDER

R-47588 R-5666
Application No. 47589 Permit No. 35327
IN NAME OF

GENE DUNAWAY

Surveyed APR. 17, 1975, by L.H. NUNN