


T.10S. R.6W. W.M.

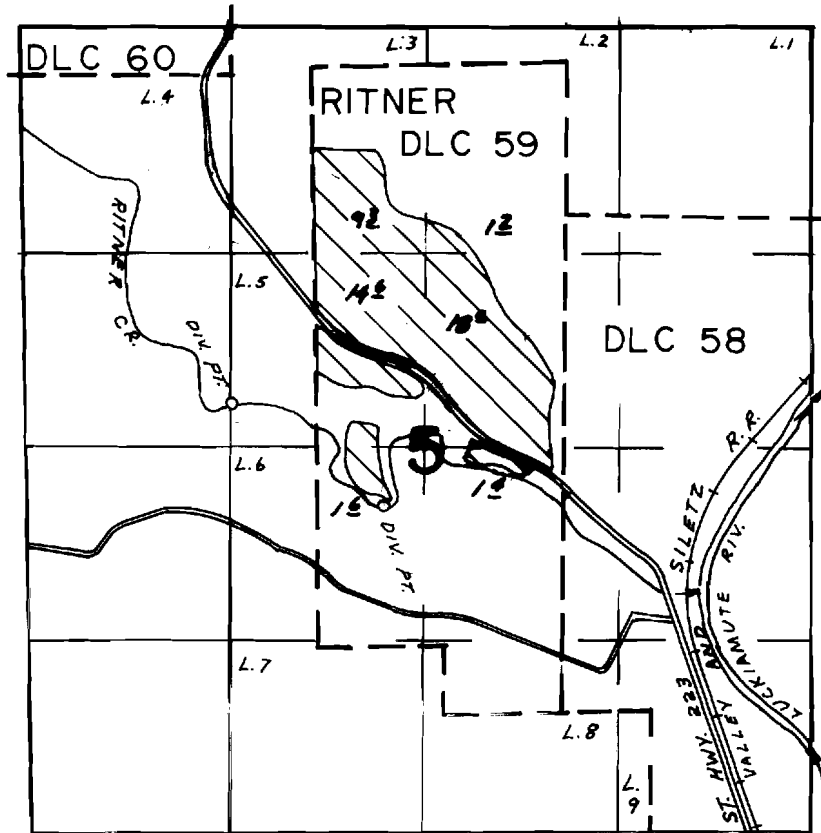

N. DIV. PT. LOC. 2090'N. & 2860'W. } BOTH FROM NE
 S. DIV. PT. LOC. 1400'N. & 1820'W. } COR. GOVT. LOT 9

FINAL PROOF SURVEY UNDER

Application No. 48425... Permit No. 36240...
 IN NAME OF

HENRY R. & JOAN G. KAISER

Surveyed OCT. 16... 1975... by L.H. NUNN...