


T.6S., R.3W., W.M.

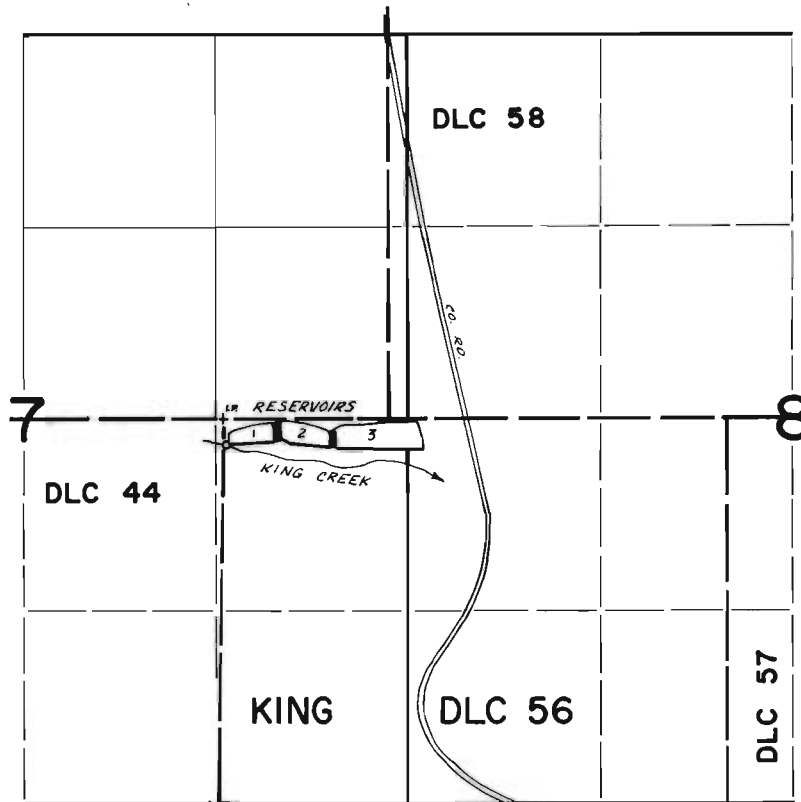

DIV. PTS. LOC. CR. - 180'S & 20'E; RES. #1 - 100'S & 220'E; RES. #2 - 100'S & 570'E AND RES #3 - 120'S & 1080'E FROM NW COR. KING DLC 56.

**FINAL PROOF SURVEY**  
UNDER

R-48819                      R-5921  
Application No. 48820      Permit No. 36594  
IN NAME OF

DUANE CASE

Surveyed June 11 1975 by D. Norby