


T.6S. R.6W. W.M.

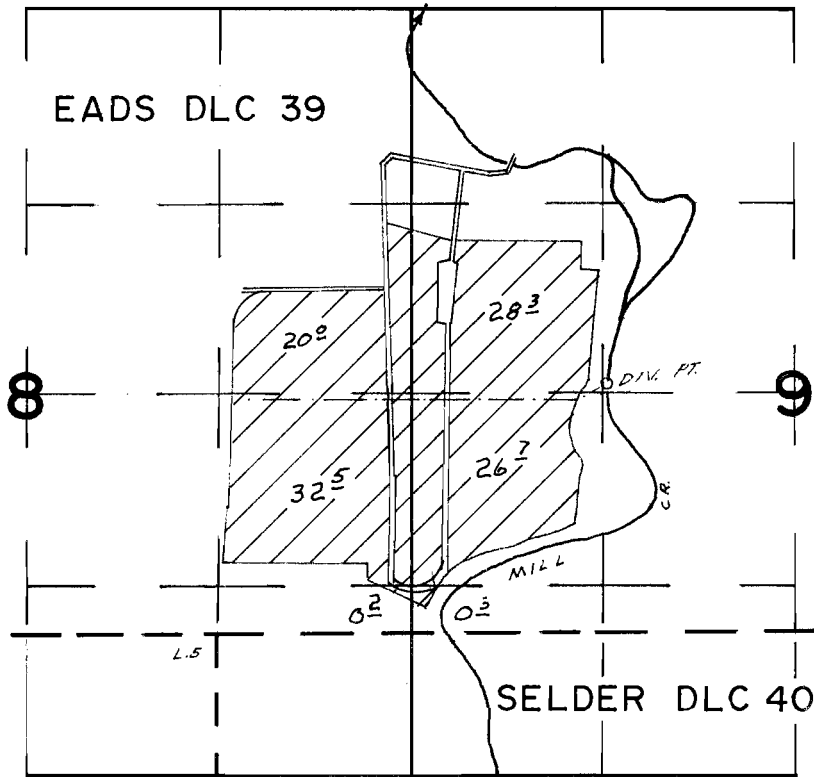

DIV. PT. LOC. 1750' N & 2660' E FROM NW COR. SELDER DLC 40

FINAL PROOF SURVEY

UNDER

Application No. 50416 Permit No. 36768

IN FAVOR OF

RAYMOND L. RICE

Surveyed OCT. 14 1975, by L.H. NUNN