


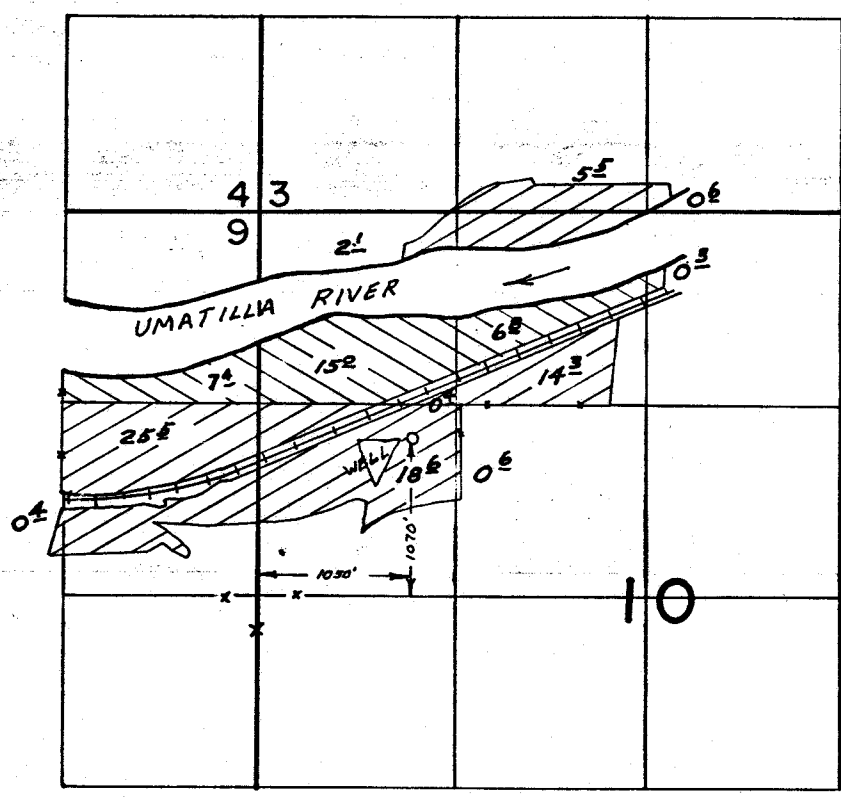

T.2N. R.30E. W.M.



Primary 

Supplemental 

FINAL PROOF SURVEY UNDER

Application No. G-4840 Permit No. G-4561.
IN NAME OF
ELSIE PORTER ROSS JOHNSON
Surveyed APR. 11, 1975, by L.H. NUNN