


G 4772
45217

T.1N. R.32E. W.M.

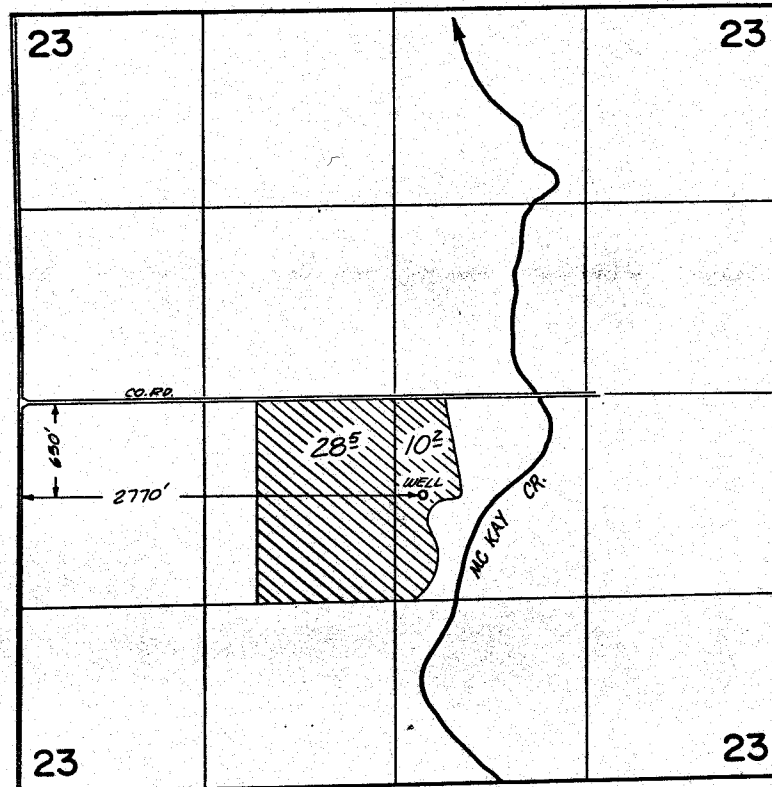

FINAL PROOF SURVEY
UNDER

Application No. G 5062 Permit No. G 4772
IN NAME OF

Milo Adkinson

Surveyed OCT 15 1975, by D. NORBY