


T.2N. R.40E. W.M.

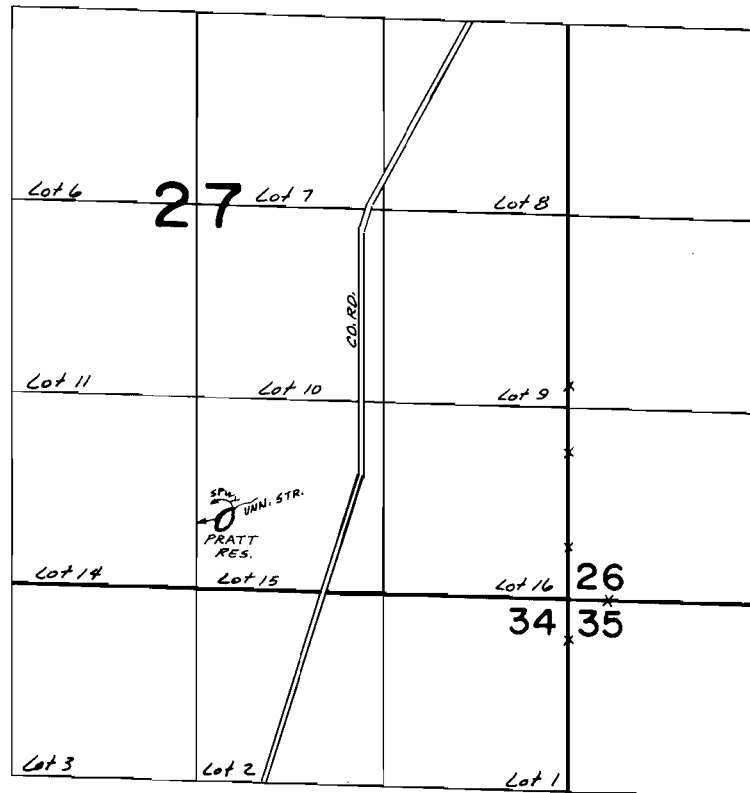

Res. - 560' N & 2410' W from SE cor Sec 27

FINAL PROOF SURVEY
UNDER

Application No. R.48961 Permit No. R.5941
IN NAME OF

Willis A. Pratt

Surveyed APRIL 4 1975, by D. NORBY