


T. 1 N. R. 38 E. W. M.

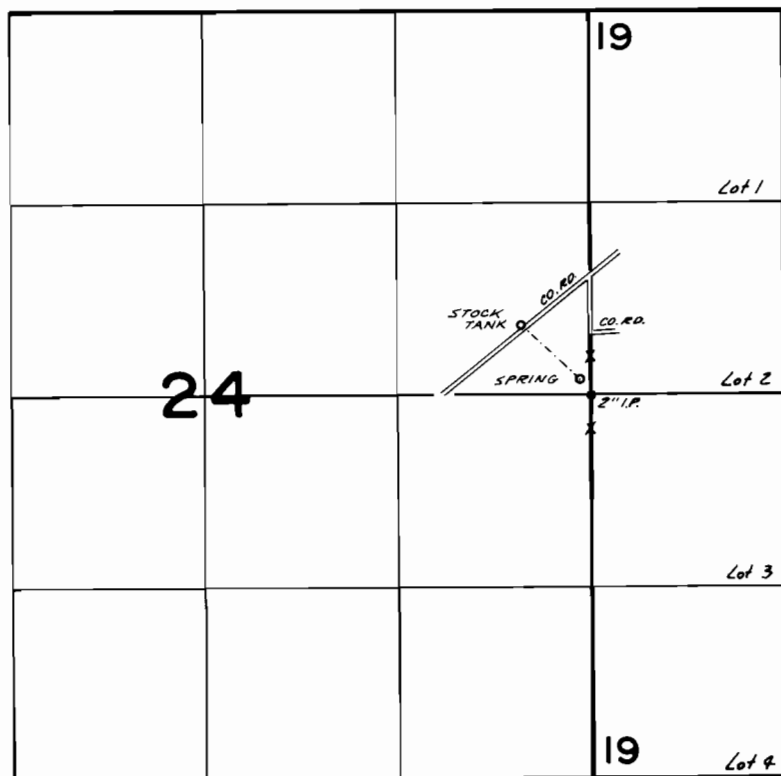

SPRING - 100' N. & 50' W. FROM E 1/4 COR. SEC. 24

FINAL PROOF SURVEY
UNDER

Application No. 49009 Permit No. 36105
IN NAME OF

Carroll J. & Katherine Baylink

Surveyed April 2 1975, by D. NORBY