


T.3S. R.40E. W.M.

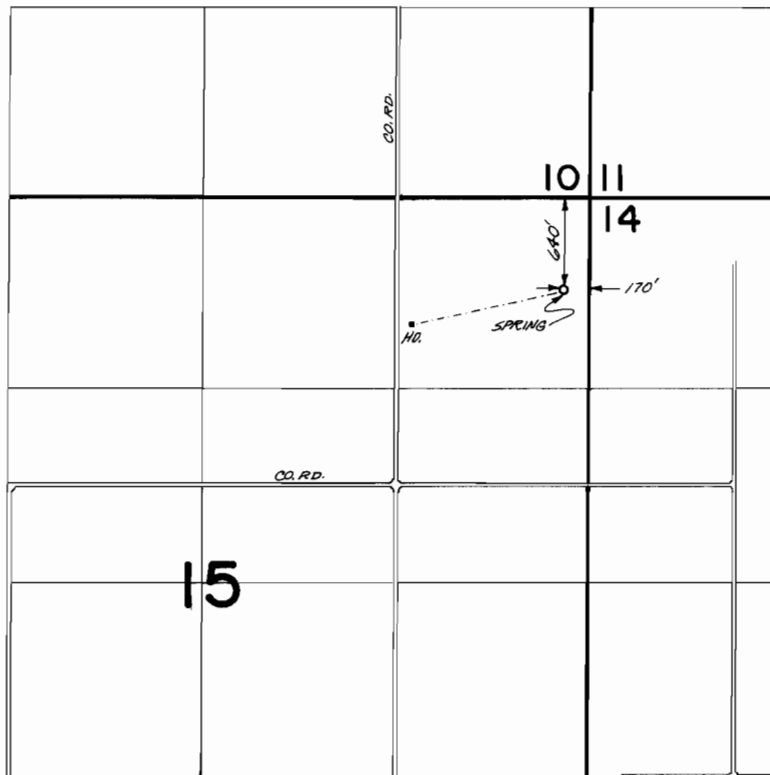

**FINAL PROOF SURVEY**  
UNDER

Application No. 49795. Permit No. 37462.  
IN NAME OF

Richard W. & Lyda L. Holland

Surveyed April 4, 1975, by D. Norby