


T.1S., R.3W., W.M.

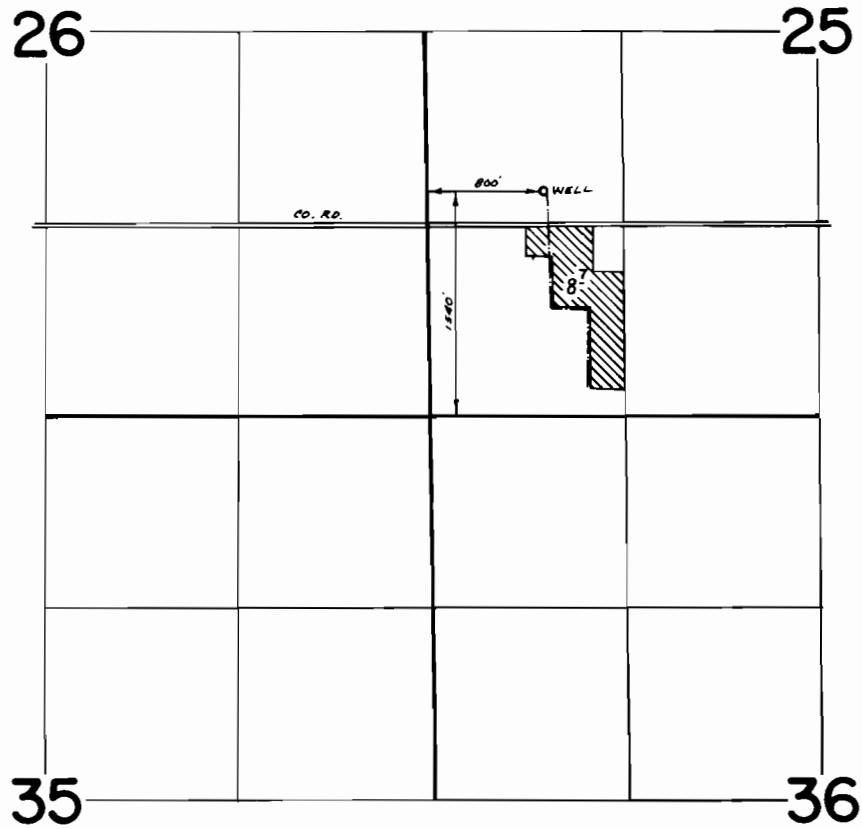

FINAL PROOF SURVEY
UNDER

Application No. G-5532 Permit No. G-5417
IN NAME OF
IRA BARBY

Surveyed Oct. 9 1975, by D. Norby