


T.1S., R.4W., W.M.

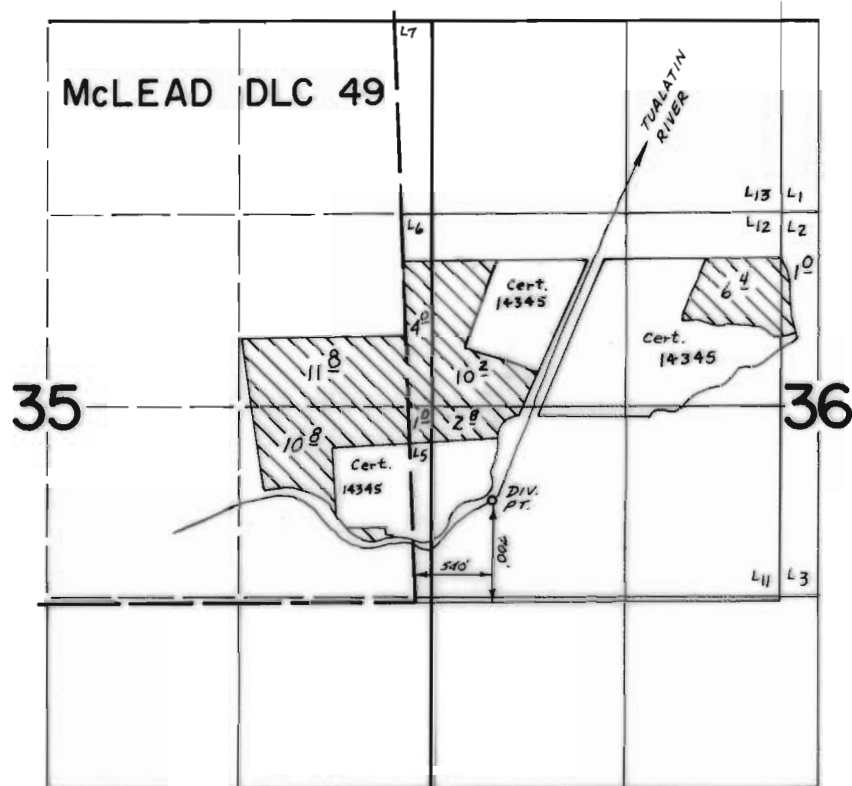

FINAL PROOF SURVEY UNDER

Application No. 49501 Permit No. 37072
IN NAME OF

ROBERT W. AND JANET L. WISMER

Surveyed Oct. 9 1975, by D. Norby