


T.12S., R.6W., W.M.

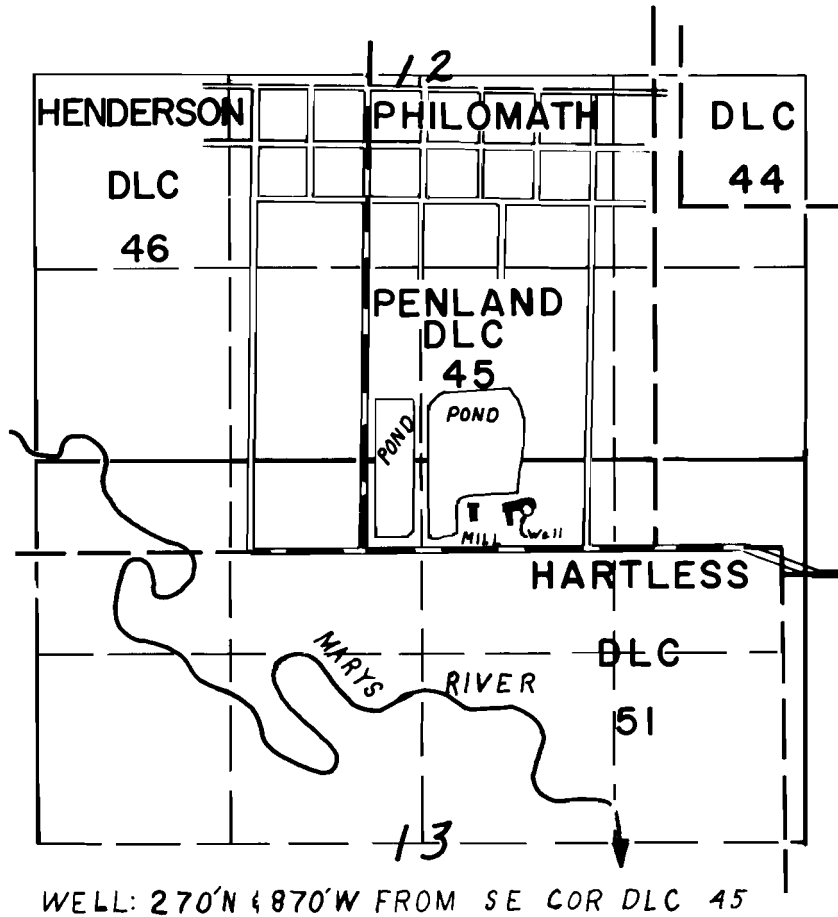

FINAL PROOF SURVEY
UNDER

Application No. G-5401. Permit No. G-5326
IN NAME OF

HOBIN FOREST PRODUCTS, CORP.

Surveyed MAR. 31. 1976, by C. R. KING...