


T.3 S. R.2 E. W.M.

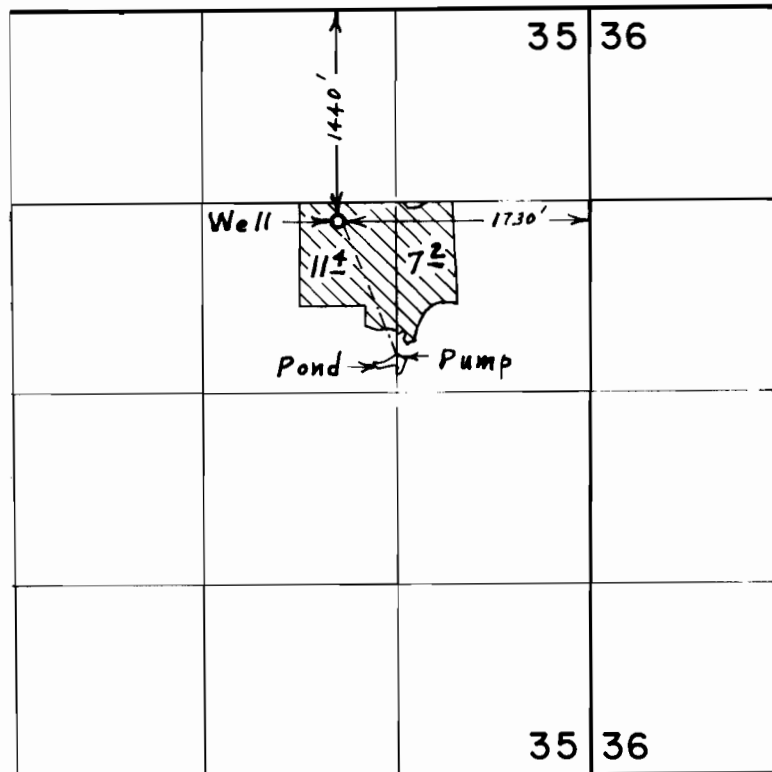

FINAL PROOF SURVEY
UNDER

Application No. G-3840 Permit No. G-3618
IN NAME OF

BERT DEARDORFF

Surveyed July 9, 1976, by L. E. Gould