


T.2S.R. 2 E.W.M.

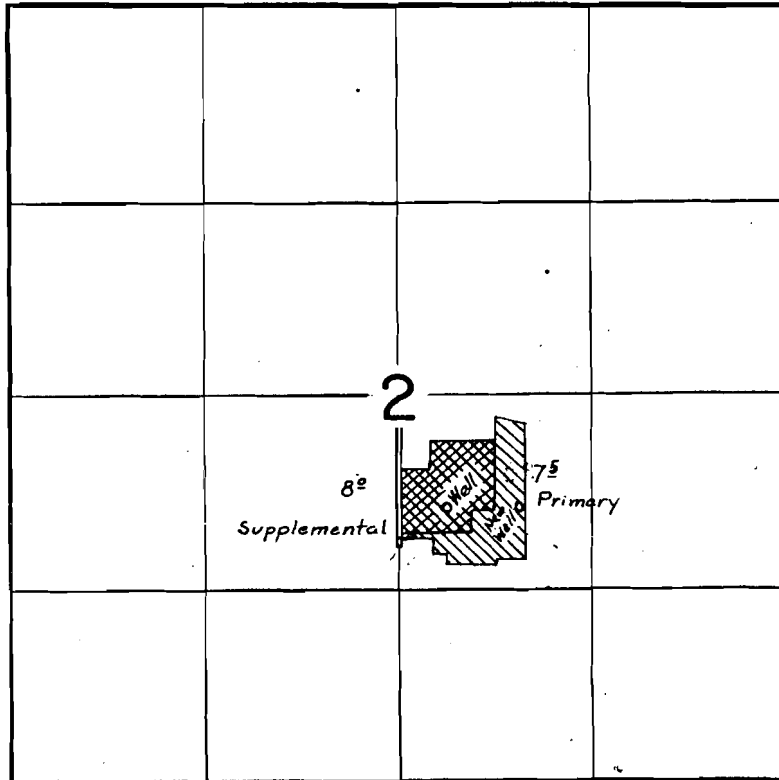


Supplemental


Primary

FINAL PROOF SURVEY

UNDER

Application No. G-5593

Permit No. G-5448

Application No. G-1262. Permit No. G-1084.
IN NAME OF

GLENN N. SAVAGE, DBA RHODODENDRON NURSERY

Surveyed April...5... 1961., by 