


T. 5 S. R. 1 E. W.M.

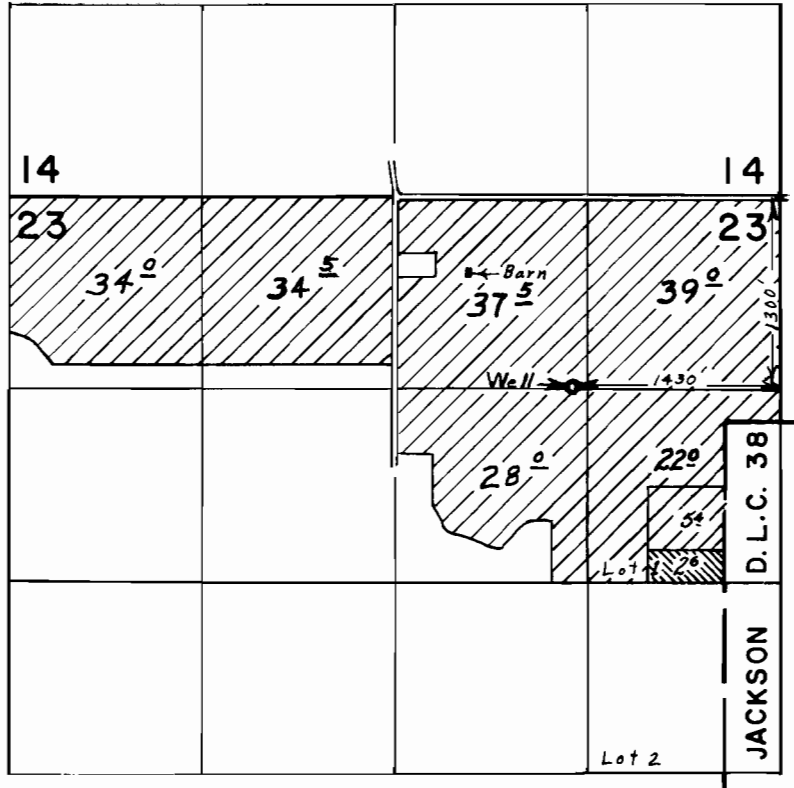

FINAL PROOF SURVEY UNDER

Application No. G-6537. Permit No. G-5807.
IN NAME OF

CRESTVIEW FARMS INC.

Surveyed April 1, 1976, by L. E. Gould.