


T. 4 S. R. 1 E. W. M.

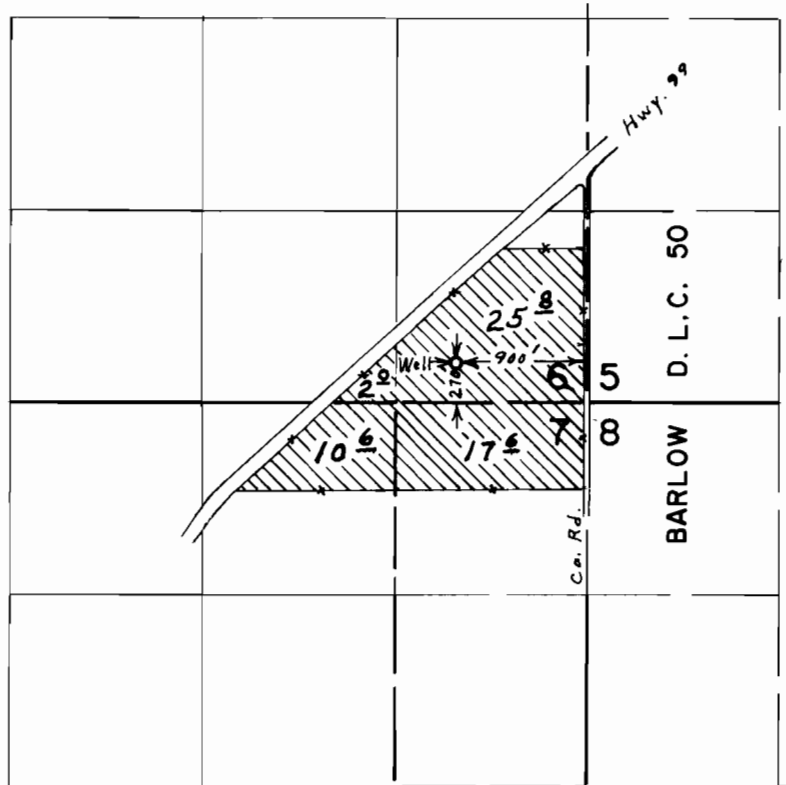

FINAL PROOF SURVEY
UNDER

Application No. G-6670 Permit No. G-6225
IN NAME OF

WILLIAM & LYDIA STACH

Surveyed April 20, 1976, by L. E. Gould