


T. 4 S. R. 1 E. W. M.

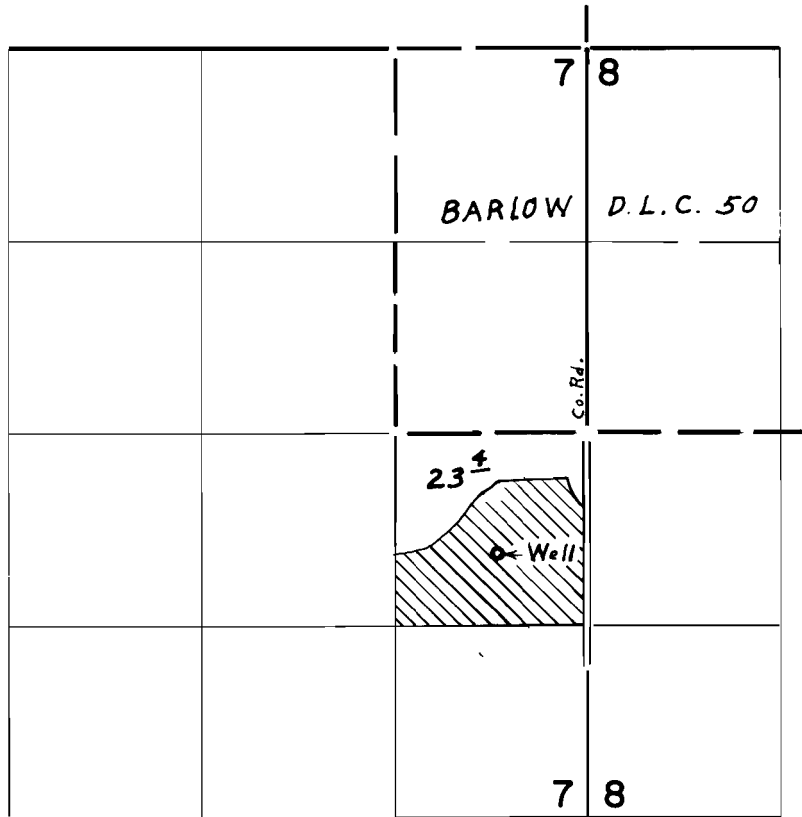

WELL LOC: 825' S. & 575' W. FROM E. 1/4 COR. SEC. 7

FINAL PROOF SURVEY
UNDER

Application No. G-6805 Permit No. G-6310
IN NAME OF

GLEN ARNESON

Surveyed March 30, 1976, by L. E. Gould