


T.3 S. R. 4 E.W.M.

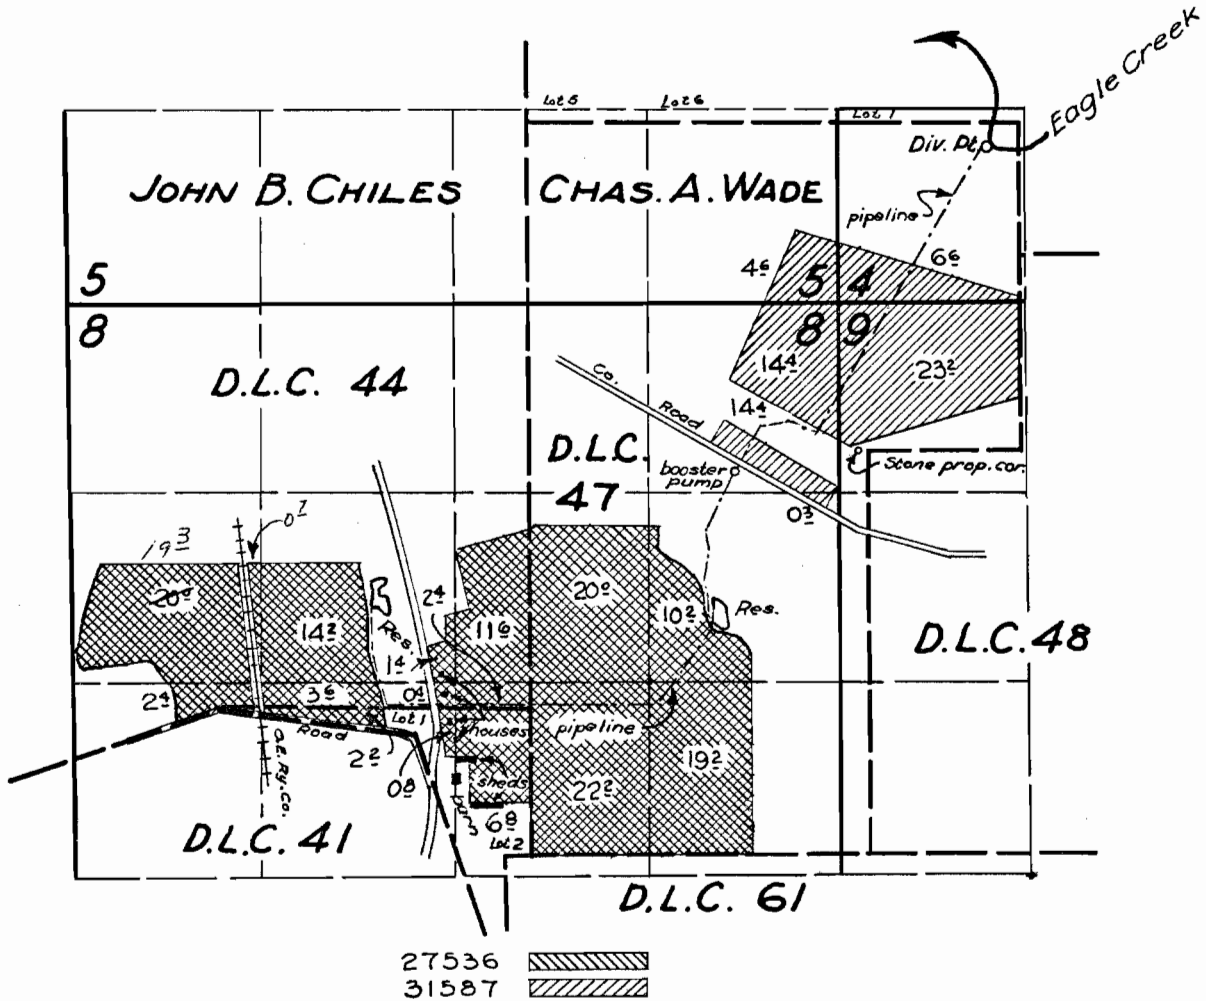

FINAL PROOF SURVEY UNDER

R-27502 R-1412
27536 21693
Application No. 31587... Permit No. 24875...
IN NAME OF

HARVEY BARNARD

29 Aug. M. Bish
Surveyed 6 Oct. 1958, by W.N. Perry

**PORTION BEING
CANCELED
FROM 2 RES.**

RECEIVED
SEP 18 1977

DEPT. OF WATER RESOURCES DEPT.
SALMON, OREGON