


T.6 S. R.2 E. W.M.

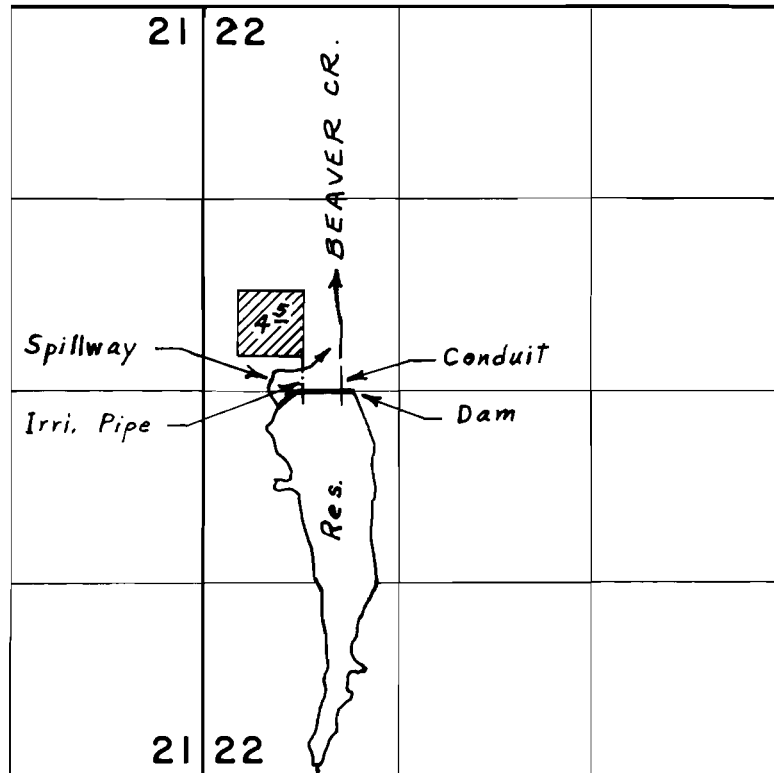

FINAL PROOF SURVEY
UNDER

R-45033 R-5148
Application No. 45034 Permit No. 33193
IN NAME OF
NEIL BEYER

Surveyed Sept. 7, 1976, by L. E. Gould