


T.2 S. R.5 E. W.M.

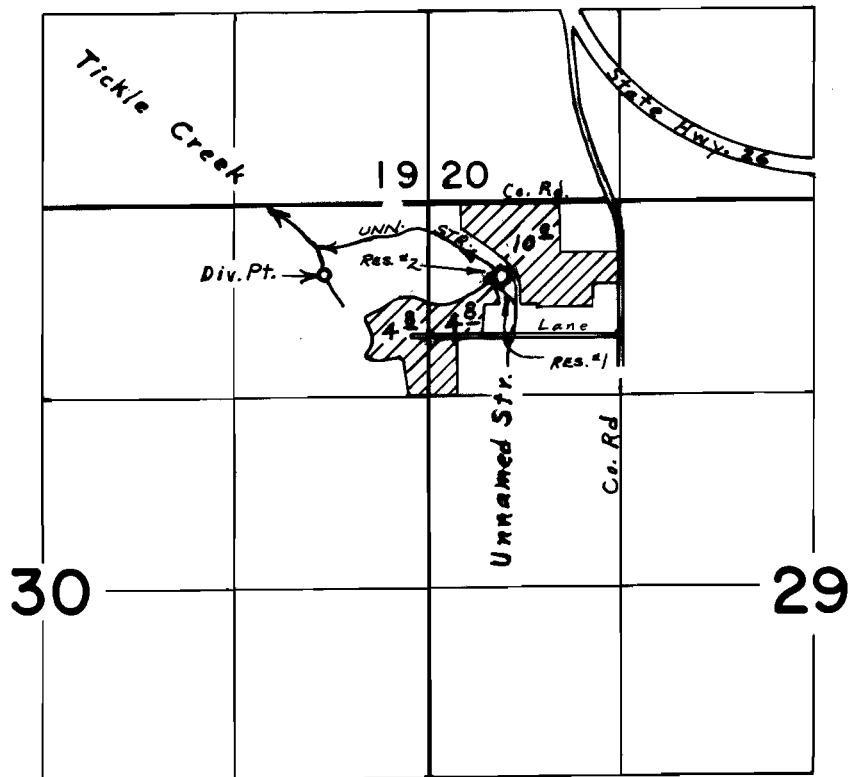

DIV. PTS. Loc. RES. #2 - 470'S. & 470'E.
RES. #1 - 550'S. & 530'E.
TICKLE CR. - 480'S. & 720'W, ALL FROM N.W. COR. SEC. 29

FINAL PROOF SURVEY
UNDER

R-47490 R-5722
Application No. 47467 Permit No. 35557
IN NAME OF

NORMAN B. ERICKSON

Surveyed Oct. 15, 1976, by L. E. Gould