


T.4 S. R.3 E, W.M.

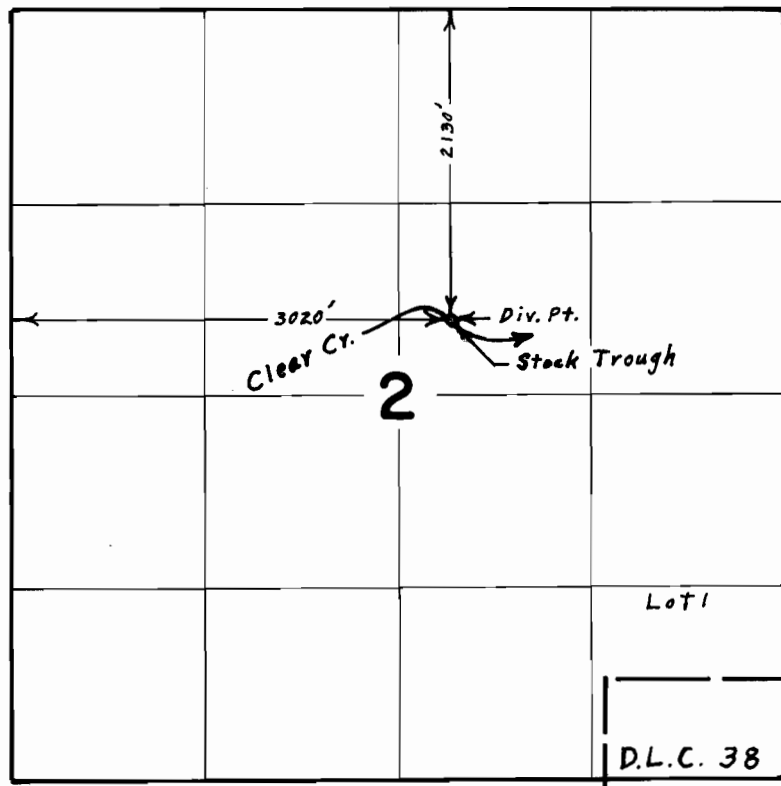

FINAL PROOF SURVEY
UNDER

Application No. 47987 Permit No. 35994

IN NAME OF

MRS. HAROLD VOHS

Surveyed April 19, 1976, by L. E. Gould