


T.2 S. R.2 E. W.M.

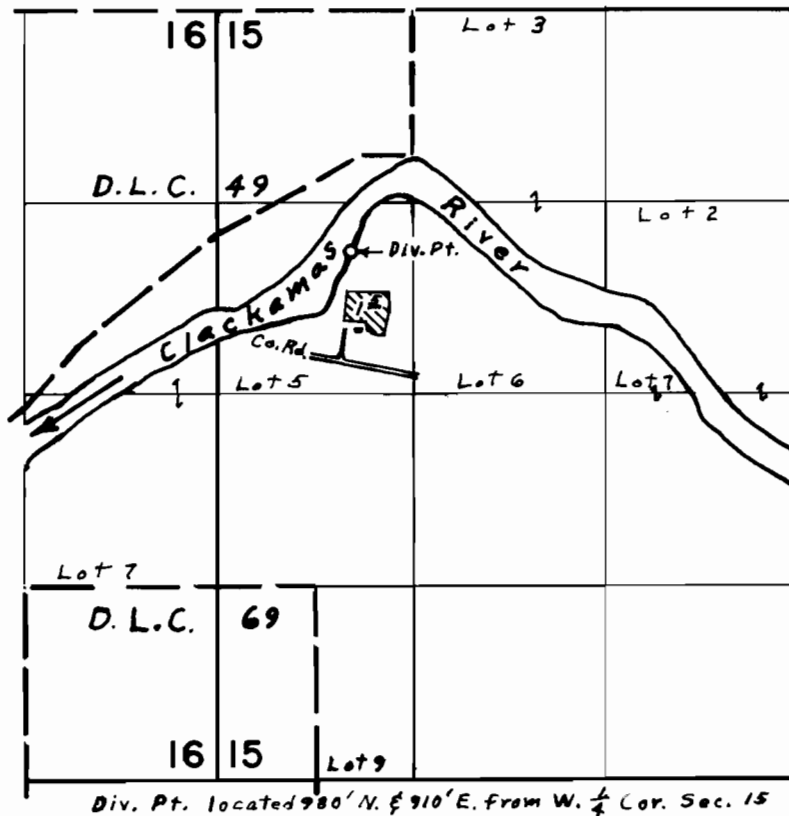

FINAL PROOF SURVEY UNDER

Application No. 49020 Permit No. 36691
IN NAME OF

DONALD F. PLYMPTON

Surveyed Oct. 8, 1976, by L. E. Gould