


T.6 S. R.2 E. W.M.

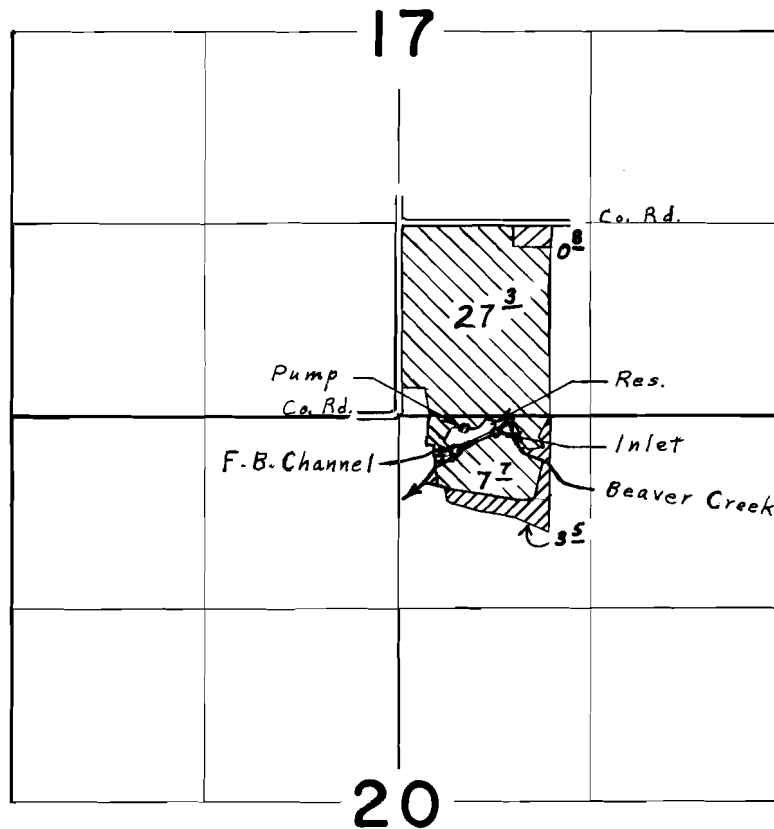

Primary 
Supplemental 

FINAL PROOF SURVEY
UNDER

R-50809 R-6188
Application No. 50810 Permit No. 38364
IN NAME OF

EDWIN MUILENBURG

Surveyed April 2, 1976, by L. E. Gould