


T.3 S. R.1 E. W.M.

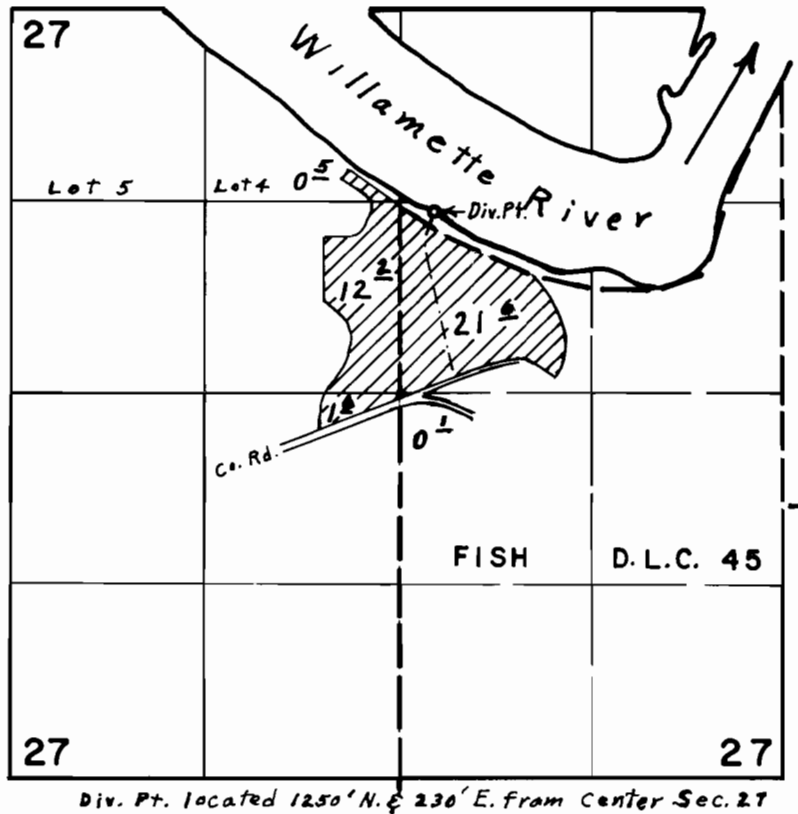

FINAL PROOF SURVEY UNDER

Application No. 52672.. Permit No. 37827..

IN NAME OF
OREGON STATE
PARKS & RECREATION BRANCH

Surveyed July 6., 1976., by L. E. G. o. u. l. d..