


T. 3 S. R. 1 E. W. M.

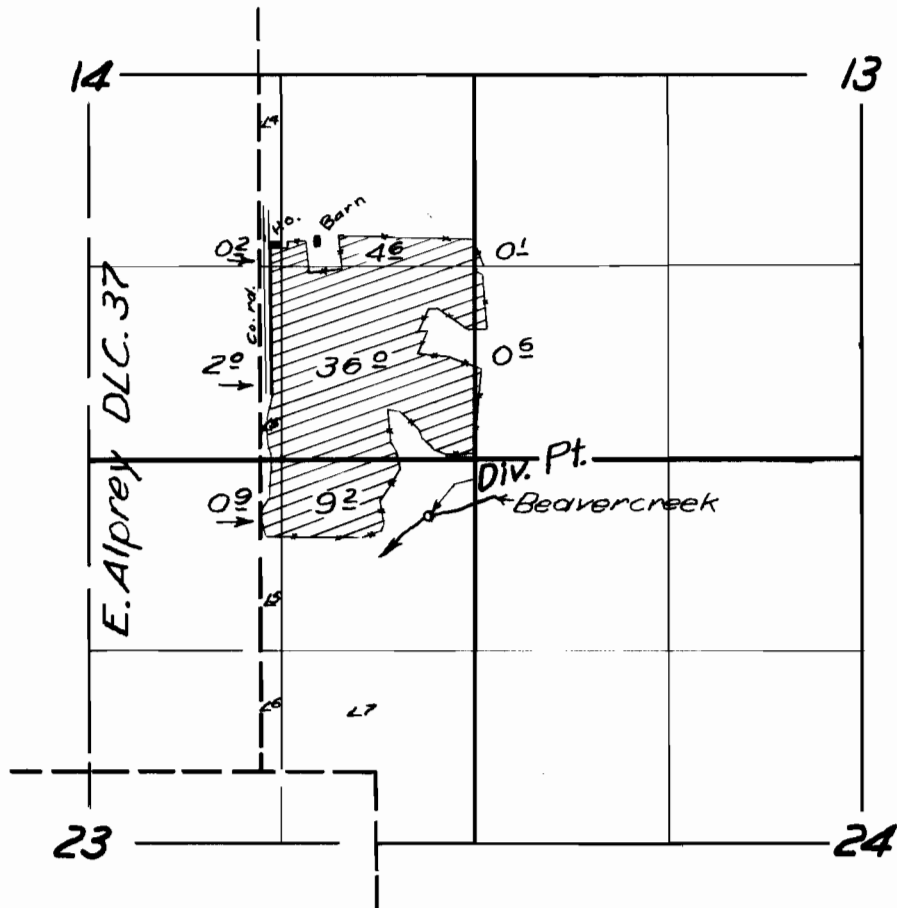

FINAL PROOF SURVEY

UNDER

Application No. 26979 Permit No. 21192

IN NAME OF

George F. Gould

Surveyed 3 Aug. 1956, by Tom B. Bohn