


# T.32S. R.4W. W.M.

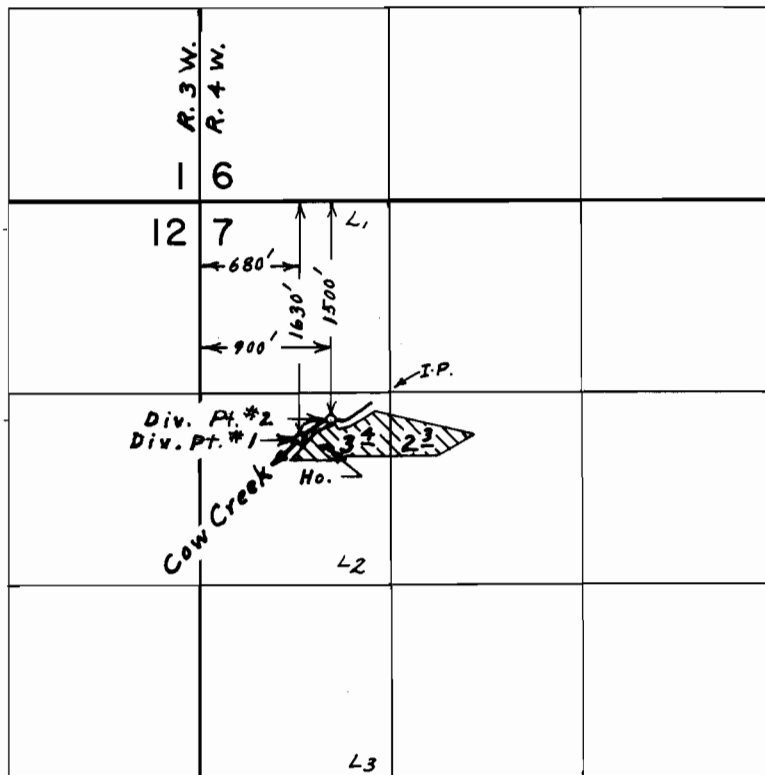

## FINAL PROOF SURVEY UNDER

Application No. 44694 Permit No. 33463  
 IN NAME OF  
**MAURICE H. WATERS**

Surveyed April 7, 1976, by L. E. Gould

NOTE: THIS SKETCH MAP MORE ACCURATELY PLACES  
DIV. PTS. & LAND W/IN SEC. 7. LAYOUT OF F.P. MAP  
PRIOR TO APPROVAL OF DEPENDENT RESURVEY &  
SUBDIVISION DONE IN 1971 AND APPROVED IN  
1977

