


T.32S. R.6W. W.M.

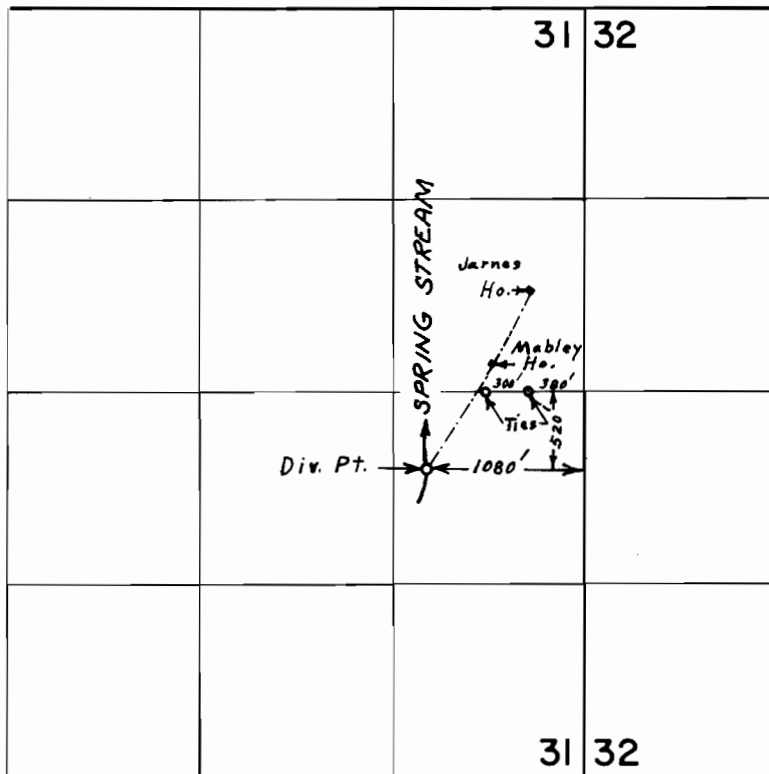

FINAL PROOF SURVEY
UNDER

Application No. 48127 Permit No. 36137
IN NAME OF

PETER C. JARNES

Surveyed April 14, 1976, by L. E. Gould