


# T.22S.R.7W.W.M.

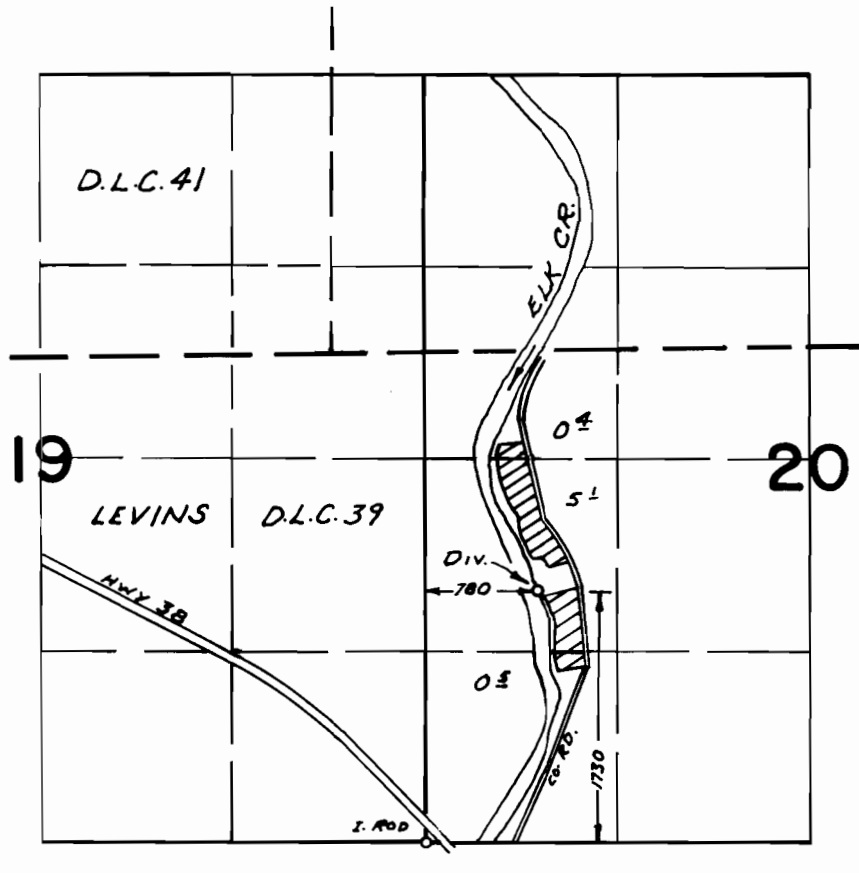

## FINAL PROOF SURVEY UNDER

Application No. 50003 Permit No. 36736  
IN NAME OF

MASON D. PADELFOED

Surveyed MAY 11 1976, by R. MUCKEN