


T.32S. R.6W. W.M.

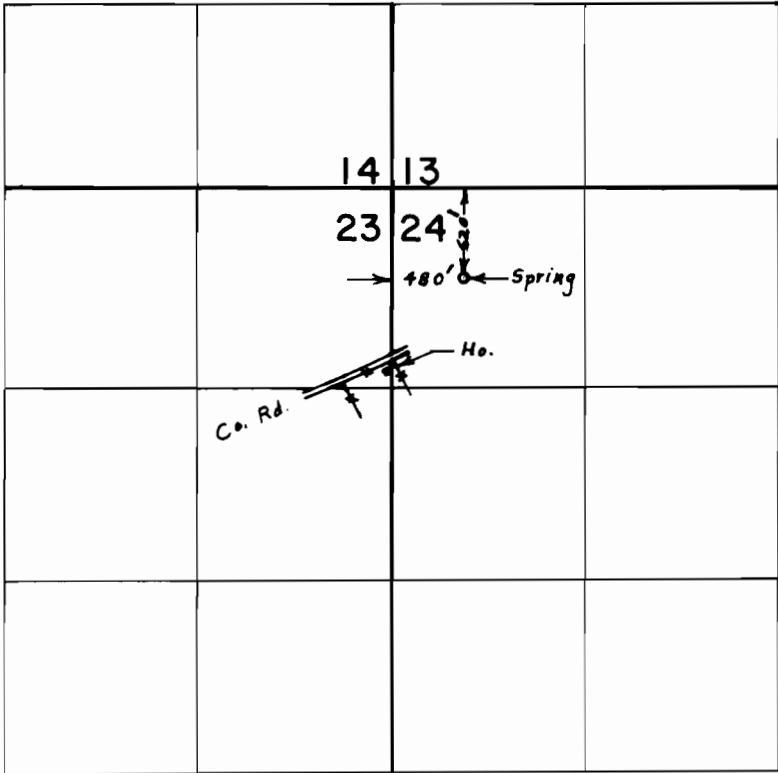

FINAL PROOF SURVEY
UNDER

Application No. 50533 Permit No. 38156
IN NAME OF

MRS. ELIZABETH VAN DUINE

Surveyed April 8, 1976, by L. E. Gould