


T.32S. R.6W. W.M.

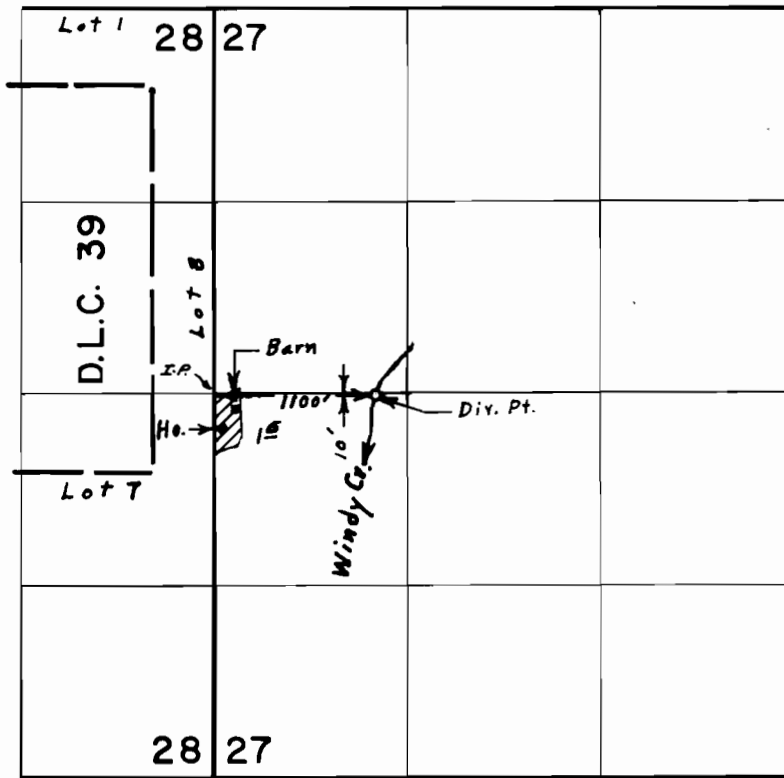

**FINAL PROOF SURVEY**  
UNDER

Application No. 50575 Permit No. 38181....  
IN NAME OF  
**DON C. MAY**

.....  
Surveyed April 9, 1976. by L. E. Gould.