


T.30S. R.6W. W.M.

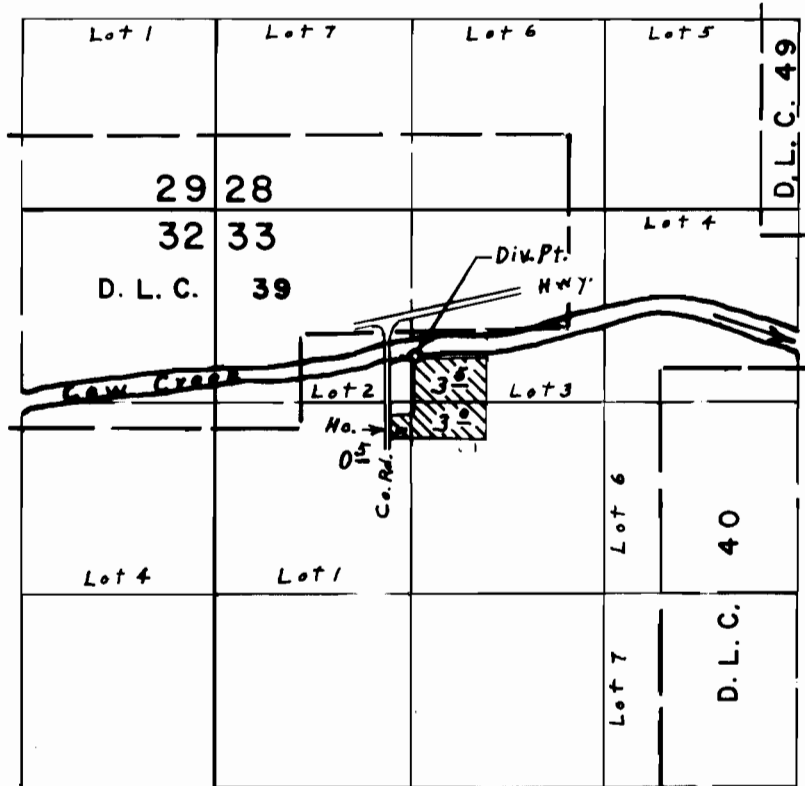

Div. Pt. located 1000'S. & 1370'E. from N.W. Cor. Sec. 33

FINAL PROOF SURVEY UNDER

Application No. 51249 Permit No. 38709
IN NAME OF

PRESTON MAIN

Surveyed April 16, 1976, by L. E. Gould