


T.32S. R.6W. W.M.

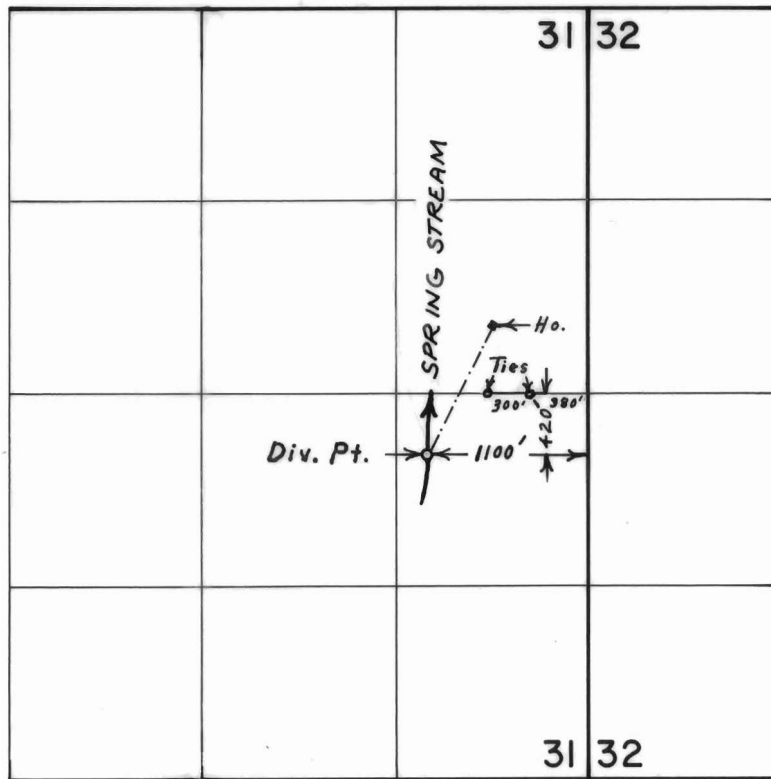

FINAL PROOF SURVEY
UNDER

Application No. 52184 Permit No. 39294
IN NAME OF

LOUIE & AGNES PAINTER

Surveyed April 13, 1976, by L. E. Gould