


# T.29 S. R.5 W. W.M.

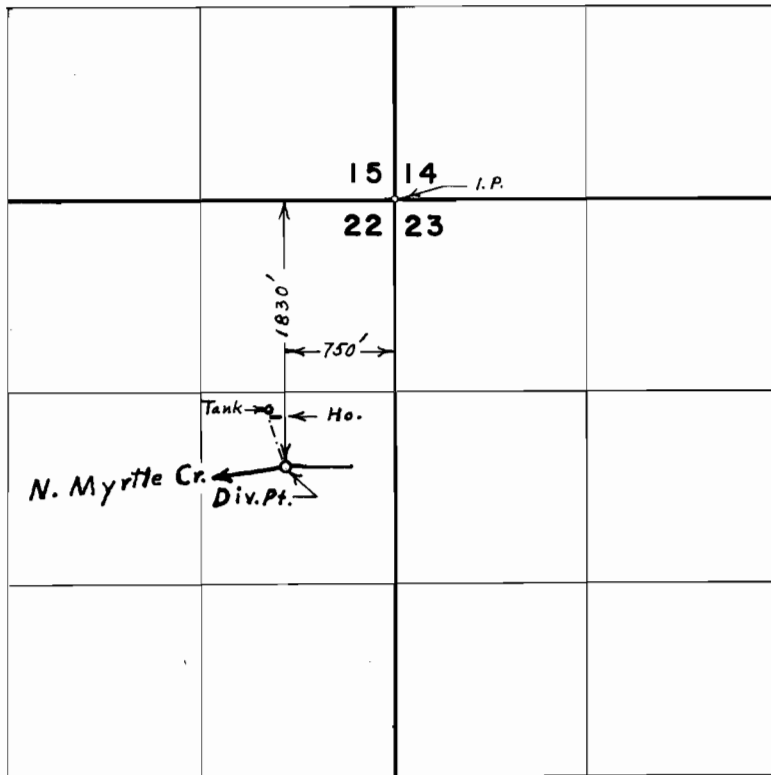

*CHANGED* *INSR*  
*Bd*

## FINAL PROOF SURVEY UNDER

Application No. 52361 Permit No. 39395  
IN NAME OF

EVERETT E. COOK

Surveyed April 15, 1976, by L. E. Gould