


T.2N., R.10E., W.M.

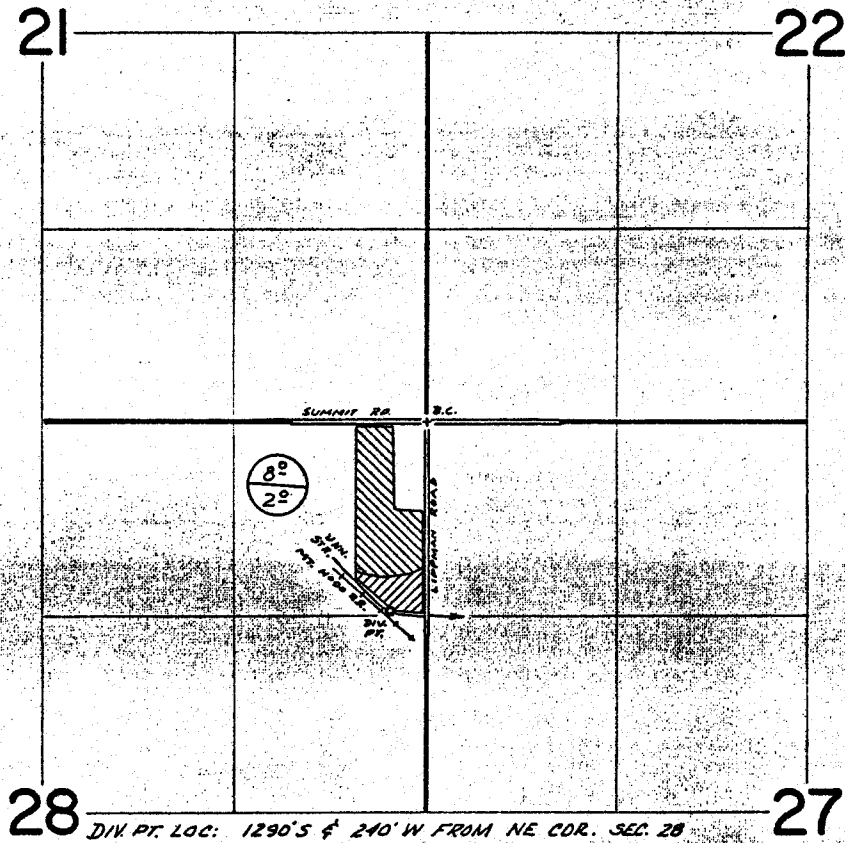

FINAL PROOF SURVEY UNDER

Application No. 43708 Permit No. 32662
IN NAME OF

Joe W. Sheirbon Jr.

Surveyed April 16 1975 by D. Norby