


# T.35S., R.2W., W.M.

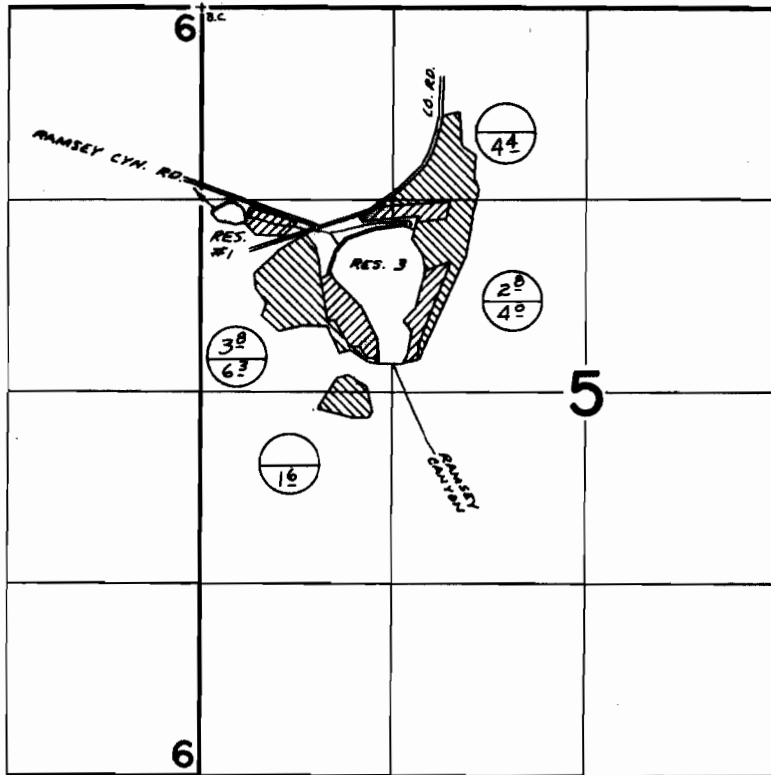

RES. LOC: 1- 1380'S & 100'E; 3- 1630'S & 990'E BOTH FROM NW COR. SEC. 5

- PRIMARY FROM RES. 1 UNDER APP. 33351
- SUPPLEMENTAL FROM RES. 3 UNDER APP. 42648
- PRIMARY FROM RES. 3 UNDER APP. 42648

## FINAL PROOF SURVEY UNDER

R-33350  
33351  
R-42647

R-2274  
26370  
R-4730

Application No. 42648 Permit No. 31249

IN NAME OF

DAVID W. SIMPSON

June 24 65 L. Colebank  
Surveyed May 1 1975, by D. Norby