



T.35S., R.2W., W.M.

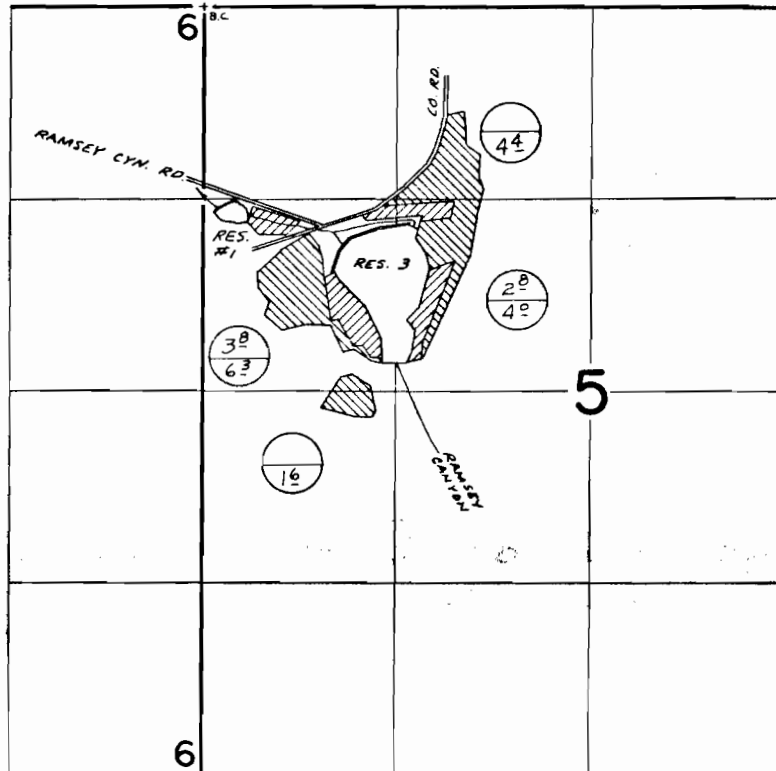

RES. LOC: 1- 1380' S & 100' E; 3- 1630' S & 950' E BOTH FROM NW COR. SEC. 5

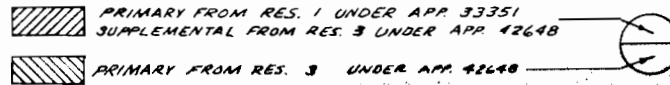

FINAL PROOF SURVEY
UNDER

R-33350 R-2274
 33351 26370
 R-42647 R-4730

Application No. 42648 Permit No. 31249

IN NAME OF

DAVID W. SIMPSON

June 24 65 L. Colebank
 Surveyed May 1 1975, by D. Norby