


T.35S., R.2W., W.M.

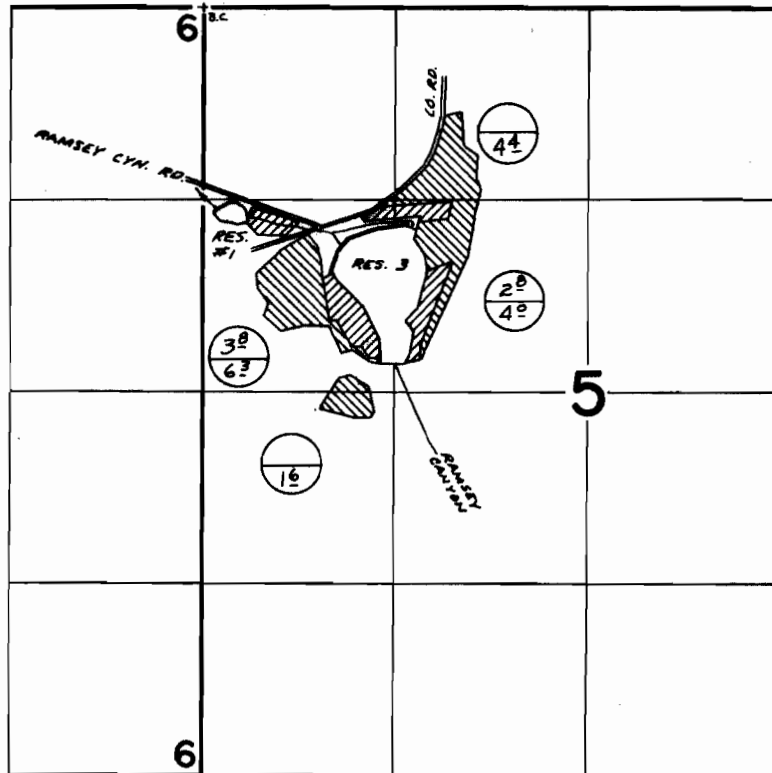

RES. LOC: 1- 1380' S & 100' E; 3- 1630' S & 990' E BOTH FROM NW COR. SEC. 5

 PRIMARY FROM RES. 1 UNDER APP. 33351
 SUPPLEMENTAL FROM RES. 3 UNDER APP. 42648
 PRIMARY FROM RES. 3 UNDER APP. 42648

FINAL PROOF SURVEY UNDER

R-33350
33351
R-42647

R-2274
26370
R-4730

Application No. 42648 Permit No. 31249

IN NAME OF

DAVID W. SIMPSON

June 24 65 L. Colebank
 Surveyed May 1 1975, by D. Norby