


# T.36S.,R.2W.,W.M.

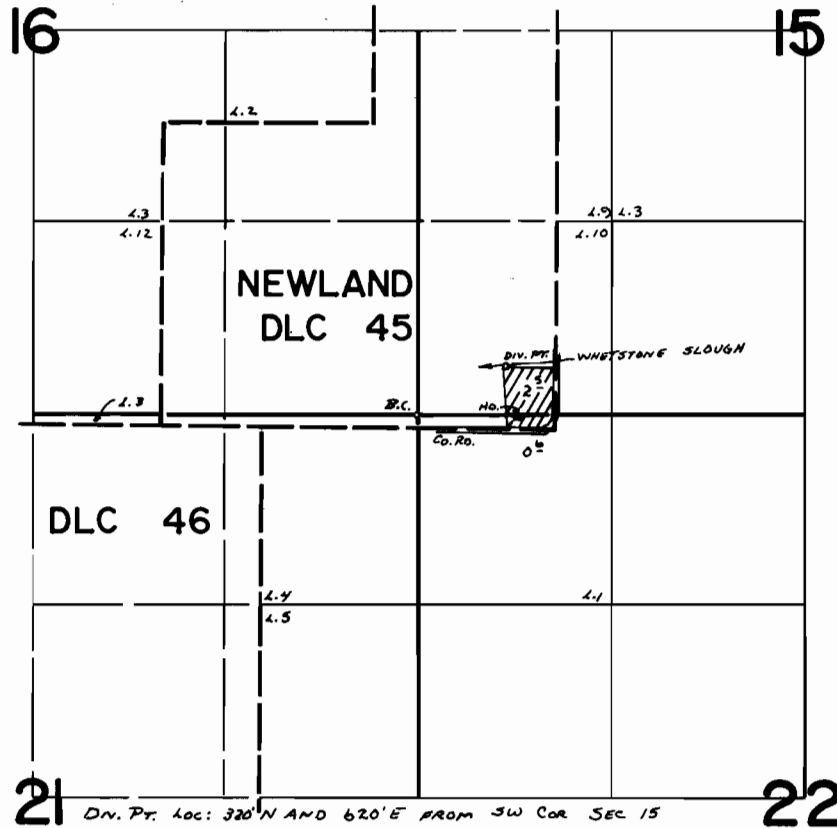

## FINAL PROOF SURVEY UNDER

Application No. 48039 Permit No. 36024  
IN NAME OF

RAY AND/OR MYRNA RICE

Surveyed Aug. 16 1975, by A. E. Goulet