


T.2N.R.39E.W.M.

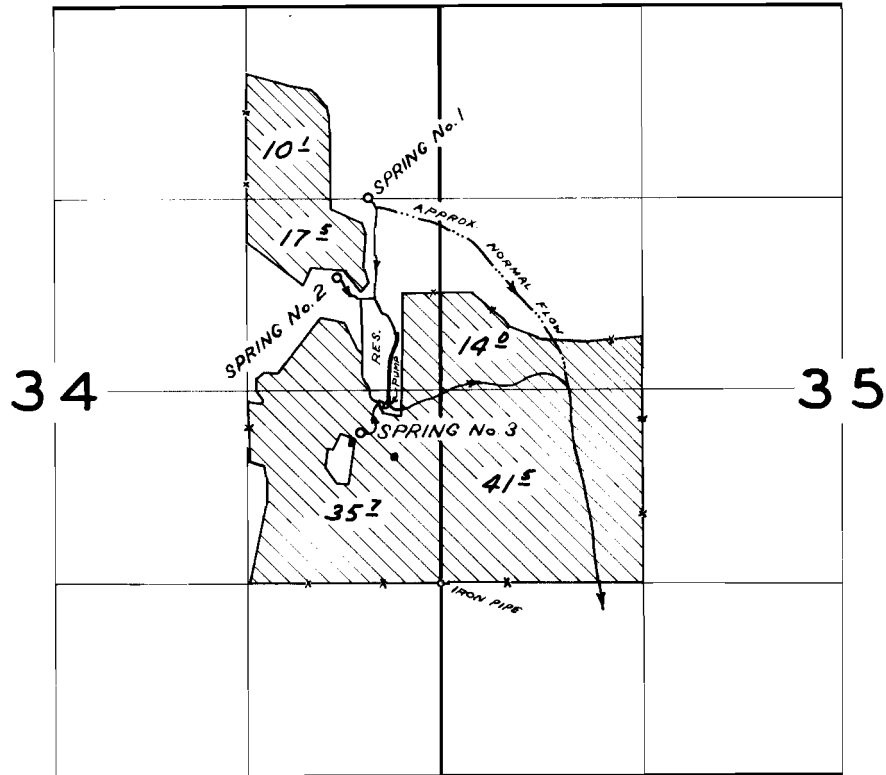

SPRING No. 1 - 2850 FT. NORTH AND 450 FT. WEST
SPRING No. 2 - 2110 FT. NORTH AND 710 FT. WEST
SPRING No. 3 - 1030 FT. NORTH AND 550 FT. WEST
ALL BEING FROM THE SW COR. NW 1/4 SW 1/4 SEC. 35

FINAL PROOF SURVEY
UNDER

Application No. 143 Permit No. 47

IN NAME OF

CLIFFORD TERRY

Surveyed Oct. 26 1965, by C. GARDNER