


33390

45300

T.33S. R.17E. W.M.

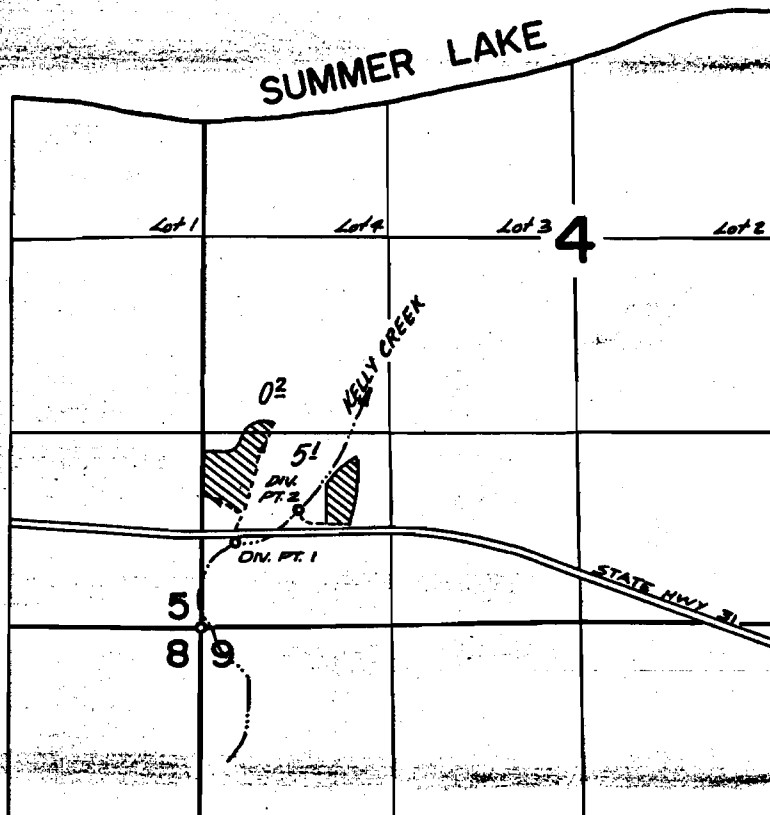

D.M. PT. 1, 600' N. & 220' E., D.M. PT. 2, 820' N. & 650' E. BOTH FROM SW. COR. SEC. 4

FINAL PROOF SURVEY
UNDERApplication No. 44628 Permit No. 33390
IN NAME OFDONALD HODGESSurveyed JULY 30 1975, by R.G. MUCKEN

ONE INCH = 100 FEET