


I, Adrian W. Vaaler, Eugene, Ore, do hereby certify that this map was made from notes taken during an actual survey made by me on May 10-18, 1956; that 1" pipe markers at wells 1, 2, 3, and 4 are located as follows from the N.N.E. CORNER of the P. COMEGYS D.L.C. No. 80 in T17S R2W W.M.

Well No 1	- Bears	N 81° 36' E	1447.5 ft.
" No 2	"	N 85° 18' E	1562.06 ft.
" No 3	"	N 88° 32 1/2' E	1681.5 ft.
" No 4	"	S 88° 41' E	1805.5 ft.

Adrian W. Vaaler
 May 22, 1956

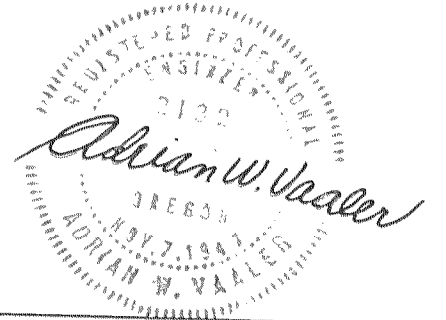

SCALE 1" = 200'

RAINBOW & MCKENZIE HIGHWAY WATER DISTRICT
 WELL AND PUMP SITE
 WATER RIGHT APPLICATION SUBVEY.

SURVEY BY A.W.VAALER C.E.
 2610 BAKER ST.
 EUGENE OREGON
 MAY 1956

Application No. G-283
 Permit No. G-237