


T.13S.,R.10W.,W.M.

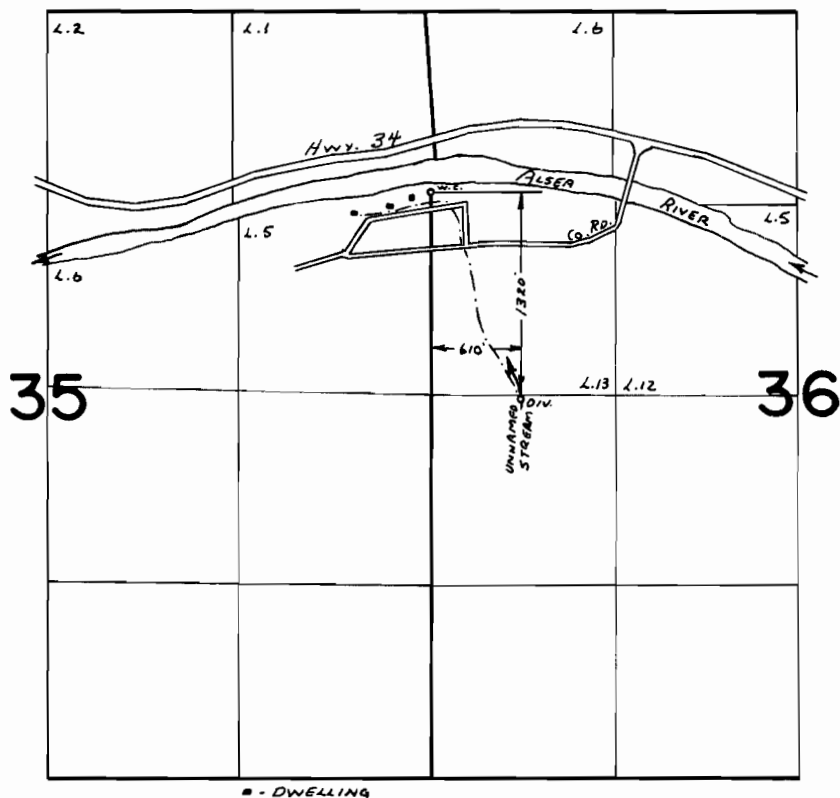

FINAL PROOF SURVEY UNDER

Application No. 41408 Permit No. 30931
IN NAME OF
ESTATE OF J. C. BARCLAY
JESSIE V. N. E., & GLADYS BARCLAY
HELEN N. COOK

Surveyed SEPT. 9 1975, by L. Toll.....